

MISSISSIPPI DEPARTMENT OF NATURAL RESOURCES

Bureau of Land and Water Resources

Southport Mall

P.O. Box 10631

Jackson, Mississippi 39209

WATER WELL DRILLERS LOG

MARION
G
2025

12/20 1985 Tombhiffith wellser Marion
 date well completed firm name county well located

LANDOWNER: Jerrell M Daniel
Old Percis - Columbia Rd
Columbia, MS 39429
 (mailing address)

description of formations encountered	from	to
Clay	1	10
P. Gravel	10	100

WELL LOCATION:
 sec. 33 T 4 N R 18 E
2 miles S of Columbia
 (distance) (direction) (nearest town)

WELL PURPOSE: Heat Pump
 (home, irrigation, municipal, industrial)

WELL COMPLETION DATA:

- (1) diameter (inches) 4"
- (2) total depth (feet) 100'
- (3) static water level (feet) 70' ^{below} _{above} top of ground.
- (4) casing PVC, 80',
 (material) (depth)
1 1/2" if telescope see back.
 (size)
- (5) screen 20', 80'
 (length) (depth to top)
4", PVC
 (size) (material)
- (6) pump 3/4 12
 (HP) (yield gpm)
elec
 (type power)
- (7) electric log no
 (yes or no)
n/a
 (organization running log)
- (8) how well bottom plugged 13/12/2


RECEIVED
 MAR 17 1986

Department of Natural Resources
 Bureau of Land and Water Resources

DRILLERS REMARKS:

If well telescopes please sketch and show depths.

GROUND LEVEL

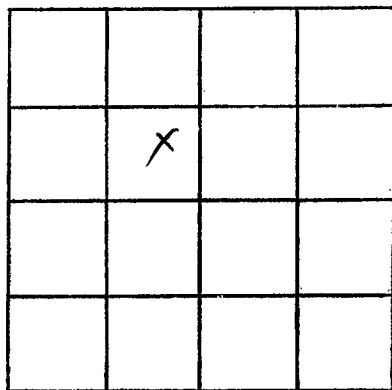

SECTION 33

Please indicate well location X.

ADDITIONAL INFORMATION

If more than one screen,
show locations of each on sketch.