

MISSISSIPPI DEPARTMENT OF NATURAL RESOURCES

Bureau of Land and Water Resources

Southport Mall

P.O. Box 10631

Jackson, Mississippi 39209

WATER WELL DRILLERS LOG

MARION
G 2027
11/7/86

19 Tom Griffith Well Service firm name MARION county well located

LANDOWNER: <u>Dr. Mark Stevens</u>	description of formations encountered	from	to
(mailing address)			
WELL LOCATION:	<u>P-GRAVEL</u>	<u>20'</u>	<u>100'</u>
sec. <u>33</u> T. <u>4</u> S. R. <u>18</u> E. <u>W</u>			
_____ miles _____ of <u>Columbia</u>			
(distance) (direction) (nearest town)			
WELL PURPOSE: <u>HEAT PUMP</u>			
(home, irrigation, municipal, industrial)			
WELL COMPLETION DATA:			
(1) diameter (inches) <u>4"</u>			
(2) total depth (feet) <u>100'</u>			
(3) static water level (feet) <u>15</u> below above top of ground.			
(4) casing <u>PVC</u> , <u>80'</u>			
(material) (depth)			
<u>4"</u> if telescope see back.			
(size)			
(5) screen <u>20'</u> , <u>80'</u>			
(length) (depth to top)			
<u>4"</u> , <u>PVC</u>			
(size) (material)			
(6) pump <u>-</u> , <u>40</u>			
(HP) (yield gpm)			
(type power)			
(7) electric log <u>No</u>			
(yes or no)			
<u>N/A</u>			
(organization running log)			
(8) how well bottom plugged <u>80%</u>			

RECEIVED


NOV 7 1986

Department of Natural Resources  
Bureau of Land & Water Resources

DRILLERS REMARKS:

If well telescopes please sketch and show depths.

GROUND LEVEL

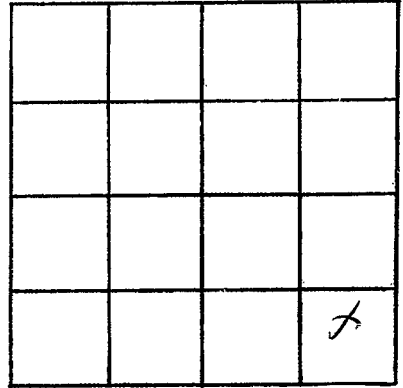

SECTION \_\_\_\_\_

Please indicate well location X.

ADDITIONAL INFORMATION

If more than one screen,  
show locations of each on sketch.