

MISSISSIPPI DEPARTMENT OF NATURAL RESOURCES

Bureau of Land and Water Resources

Southport Mall

P.O. Box 10631

Jackson, Mississippi 39209

WATER WELL DRILLERS LOG

MARION
G 2028

7-23-86 19 Tom Smith Well Service Marion
date well completed firm name county well located

LANDOWNER: <u>David Fillingame</u>	description of formations encountered	from	to
	<u>CLAY</u>	<u>0</u>	<u>10</u>
	<u>SAND</u>	<u>10</u>	<u>60</u>
(mailing address)	<u>CLAY</u>	<u>60</u>	<u>120</u>
WELL LOCATION:	<u>SAND</u>	<u>120</u>	<u>140</u>
sec. <u>35</u> T <u>4</u> N R <u>18</u> E S			
<u>5</u> miles <u>East</u> of <u>Columbia</u> (distance) (direction) (nearest town)			
WELL PURPOSE: <u>Home</u> (home, irrigation, municipal, industrial)			
WELL COMPLETION DATA:			
(1) diameter (inches) <u>4"</u>			
(2) total depth (feet) <u>140</u>			
(3) static water level (feet) <u>60</u> <u>below</u> above top of ground.			
(4) casing <u>PVC</u> <u>120'</u> (material) (depth)			
<u>4"</u> (size) if telescope see back.			
(5) screen <u>20'</u> <u>120'</u> (length) (depth to top)			
<u>4"</u> <u>PVC</u> (size) (material)			
(6) pump <u>1/2</u> <u>30</u> (HP) (yield gpm)			
<u>220 V.</u> (type power)			
(7) electric log <u>No</u> (yes or no)			
<u>NA</u> (organization running log)			
(8) how well bottom plugged <u>3/4</u>			
DRILLERS REMARKS:			


RECEIVED

NOV 7 1986

Department of Natural Resources
Bureau of Land & Water Resources

If well telescopes please sketch and show depths.

GROUND LEVEL

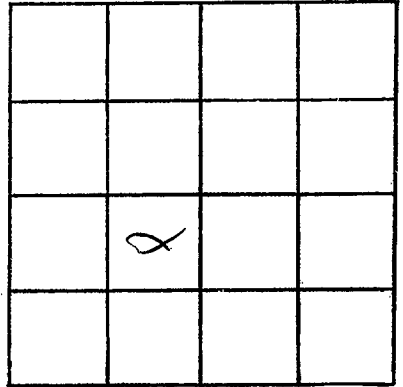

SECTION _____

Please indicate well location X.

ADDITIONAL INFORMATION

If more than one screen,
show locations of each on sketch.