

**MISSISSIPPI DEPARTMENT OF NATURAL RESOURCES**  
**Bureau of Land and Water Resources**  
 Southport Mall  
 P.O. Box 10631  
 Jackson, Mississippi 39209  
**WATER WELL DRILLERS LOG**

Marion  
G 2029

July 30 1987 Fitzgerald Well Serv Marion  
 date well completed firm name county well located


LANDOWNER:	description of formations encountered	from	to
<u>Tony McDonald</u>	<u>Red clay</u>	<u>0</u>	<u>20</u>
<u>R.R. Columbia, Ms.</u> (mailing address)	<u>Fine sand</u>	<u>20</u>	<u>137</u>
WELL LOCATION: sec. <u>26</u> T <u>4</u> N R. <u>18</u> E S W <u>1</u> miles <u>NE</u> of <u>Columbia</u> (distance) (direction) (nearest town)	<u>Coarse sand &amp; gravel</u>	<u>137</u>	<u>150</u>
WELL PURPOSE: (home, irrigation, municipal, industrial)			
WELL COMPLETION DATA:			
(1) diameter (inches) <u>4</u>			
(2) total depth (feet) <u>150</u>			
(3) static water level (feet) <u>40</u> below above top of ground.			
(4) casing <u>PVC</u> , <u>140</u> (material) (depth) <u>4</u> if telescope see back. (size)			
(5) screen <u>10</u> , <u>140</u> (length) (depth to top) <u>4</u> , <u>PVC</u> (size) (material)			
(6) pump <u>1/2</u> , <u>10</u> (HP) (yield gpm) <u>elec</u> (type power)			
(7) electric log <u>No</u> (yes or no) <u>Land Shark</u> (organization running log)			
(8) how well bottom plugged			
DRILLERS REMARKS:			

**RECEIVED**  
 AUG 27 1987

Department of Natural Resources  
 Bureau of Land & Water Resources

If well telescopes please sketch and show depths.

GROUND LEVEL

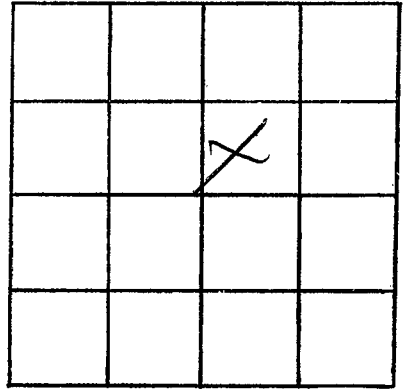

SECTION 26

Please indicate well location X.

ADDITIONAL INFORMATION

If more than one screen,  
show locations of each on sketch.