

MISSISSIPPI DEPARTMENT OF NATURAL RESOURCES

Bureau of Land and Water Resources

Southport Mall

P.O. Box 10631

Jackson, Mississippi 39209

WATER WELL DRILLERS LOG

MARION  
 CT 2036

4-4-95  
 date well completed

1995 Hollensen Well Service  
 firm name

8 MARION  
 county well located

LANDOWNER: Bob G Neal  
 26 Lakeshore DR  
 Columbia, Ms. 39429  
 (mailing address)

description of formations encountered

from to

Red clay  
 Sand, gravel

0 20  
 20 80

WELL LOCATION:

sec. 3 T 40N R 18 E  
 S W  
 2 miles E of Columbia  
 (distance) (direction) (nearest town)

WELL PURPOSE: ~~Commercial~~  
 (home, irrigation, municipal, industrial)

WELL COMPLETION DATA:

- (1) diameter (inches) 4"
- (2) total depth (feet) 80
- (3) static water level (feet) 25 below above top of ground.
- (4) casing PVC 70 (material) (depth)  
 (size) if telescope see back.
- (5) screen 10 80 (length) (depth to top)  
 4 PVC (size) (material)
- (6) pump 2 30 (HP) (yield gpm)  
 elect (type power)
- (7) electric log (yes or no)

(organization running log)

(8) how well bottom plugged Sand  
 SHARK

RECEIVED


JUN 21 1995

Dept. of Environmental Quality  
 Office of Land & Water Resources

DRILLERS REMARKS:

If well telescopes please sketch and show depths.

GROUND LEVEL

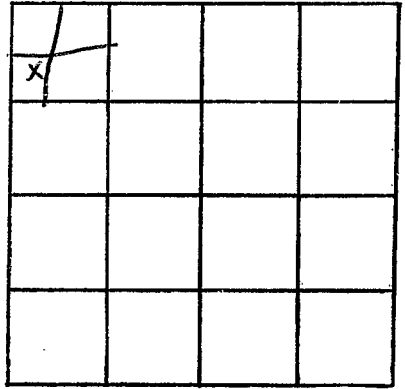

SECTION 3

Please indicate well location X.

ADDITIONAL INFORMATION

If more than one screen,  
show locations of each on sketch.