

MISSISSIPPI  
BOARD OF WATER COMMISSIONERS  
416 North State Street  
Jackson, Mississippi 39201

**CODED**

**WATER WELL DRILLERS LOG**

Marion  
H 12  
6-2-69

6/2 1969 Dean Griner Marion  
date well completed firm name county well located


LANDOWNER:	description of formations encountered	from	to
(mailing address)			
<u>Ossie Morris</u>	<u>Top soil</u>	<u>0</u>	<u>1</u>
<u>Routel Columbia Miss.</u>	<u>red clay</u>	<u>1</u>	<u>30</u>
<u>WELL LOCATION:</u>	<u>Gravel</u>	<u>30</u>	<u>80</u>
sec <u>4</u> T <u>4</u> <u>N</u> R <u>17</u> E	<u>red sand</u>	<u>80</u>	<u>105</u>
<u>S</u> <u>W</u>	<u>Chalk</u>	<u>105</u>	<u>120</u>
_____ miles of <u>Columbia</u>	<u>fine <b>CODED</b> sand</u>	<u>120</u>	<u>125</u>
(distance) (direction) (nearest town)	<u>water sand</u>	<u>125</u>	<u>150</u>
<u>WELL PURPOSE:</u> <u>House Use</u>			
(home, irrigation, municipal, industrial)			
<u>WELL COMPLETION DATA:</u>			
(1) diameter (inches) <u>4"</u>			
(2) total depth (feet) <u>150'</u>			
(3) static water level (feet) <u>125'</u> below top of ground.			
(4) casing <u>Plastic</u> , <u>140'</u> (material) (depth)			
_____ if telescope see back. (size)			
(5) screen <u>10'</u> , <u>140'</u> (length) (depth to top)			
<u>4"</u> , <u>Plastic</u> (size) (material)			
(6) pump <u>1 H.P.</u> (HP) (yield gpm)			
<u>J.B.M. submersible pump</u> (type power)			
(7) electric log <u>no</u> (yes or no)			
_____ (organization running log)			
(8) how well bottom plugged _____			
<u>DRILLERS REMARKS:</u>			

MAR 18 1970

MISS. BD. OF  
WATER COMM.

If well telescopes please  
sketch and show depths.

GROUND LEVEL

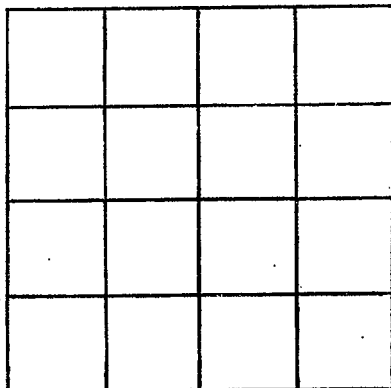

SECTION \_\_\_\_\_

Please indicate well location X.

ADDITIONAL INFORMATION

If more than one screen,  
show locations of each on sketch.