

CODED

MISSISSIPPI BOARD OF WATER COMMISSIONERS
416 North State Street
Jackson, Mississippi 39201

WATER WELL DRILLERS LOG

Marion
H 13
6-6-69

6/6 1969 date well completed
Dean Driner firm name
Marion county well located

LANDOWNER:

Edd Rayburn
Route 2 Venable, Miss.
(mailing address)

description of formations encountered

from to

Top soil 0-1'
Chalk 1-15'
Sand 15-20'
Shale & Chalk 20-362'
Water sand 362-406'

WELL LOCATION:

sec. 27 T 4 N R 17 E S
10 miles East of Columbus
(distance) (direction) (nearest town)

WELL PURPOSE: Home Use
(home, irrigation, municipal, industrial)

WELL COMPLETION DATA:

- (1) diameter (inches) 2"
- (2) total depth (feet) 406
- (3) static water level (feet) below above top of ground.
- (4) casing Plastic, 400' (material) (depth)
(size) if telescope see back.
- (5) screen 4' 402' (length) (depth to top)
2" S.S. Strainer (size) (material)
- (6) pump (HP) (yield gpm)
(type power)
- (7) electric log No (yes or no)
(organization running log)
- (8) how well bottom plugged

CODED


MAR 18 1970

MISS. BD. OF WATER COMM.

DRILLERS REMARKS:

If well telescopes please sketch and show depths.

GROUND LEVEL

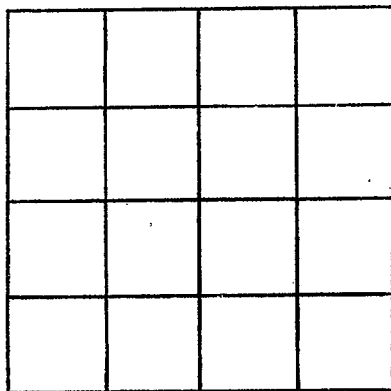

SECTION _____

Please indicate well location X.

ADDITIONAL INFORMATION

If more than one screen, show locations of each on sketch.