

MARION
 H 14
 11-69

MISSISSIPPI
 BOARD OF WATER COMMISSIONERS
 416 North State Street
 Jackson, Mississippi 39201

CODED

WATER WELL DRILLERS LOG

November 1969 E.B. Sheward Marion
 date well completed firm name county well located


LANDOWNER: <u>Hary Lowery</u> <u>Rt. 1</u>	description of formations encountered	from	to
<u>Columbia, Miss.</u> (mailing address)	<u>RED SANDY CLAY</u>	<u>0</u>	<u>70</u>
WELL LOCATION: sec. <u>19</u> T. <u>4</u> S. R. <u>17</u> E. <u>6</u> miles <u>NE</u> of <u>Columbia</u> (distance) (direction) (nearest town)	<u>FINE SAND & CLAY MIXED</u>	<u>70</u>	<u>90</u>
WELL PURPOSE: <input checked="" type="checkbox"/> (home) irrigation, municipal, industrial)	<u>GRAVEL & SAND</u>	<u>90</u>	<u>135</u>
WELL COMPLETION DATA: (1) diameter (inches) <u>2"</u> (2) total depth (feet) <u>138</u> (3) static water level (feet) <u>80</u> below above top of ground. (4) casing <u>Plastic</u> , <u>135</u> (material) (depth) <u>2"</u> if telescope see back. (size) (5) screen <u>3'</u> (length) (depth to top) <u>2 1/4"</u> <u>S.S.</u> (size) (material) (6) pump <u>1 1/2</u> <u>4</u> (HP) (yield gpm) _____ (type power) (7) electric log _____ (yes or no) _____ (organization running log) (8) how well bottom plugged <u>bn</u>	<p style="text-align: center;">CODED</p>		
DRILLERS REMARKS: _____			

FEB 5 - 1970

MISSISSIPPI
 BOARD OF WATER COMMISSIONERS
 WATER COMMISSIONERS

If well telescopes please sketch and show depths.

GROUND LEVEL

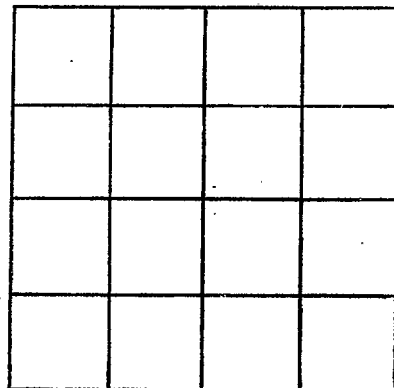

SECTION _____

Please indicate well location X.

ADDITIONAL INFORMATION

If more than one screen, show locations of each on sketch.