

MISSISSIPPI
BOARD OF WATER COMMISSIONERS
416 North State Street
Jackson, Mississippi 39201

CODED

WATER WELL DRILLERS LOG

MARION
H 15
12- 69

Dec. 19 1969 E. B. Sheppard Marion
date well completed firm name county well located

LANDOWNER:	description of formations encountered	from	to
George Hunt Rt. 2 - Columbia, Miss. (mailing address)			
WELL LOCATION: sec. 20 T. 4 N. R. 17 E. 7 1/2 miles NE of Columbia (distance) (direction) (nearest town)			
WELL PURPOSE: (home) irrigation, municipal, industrial			
WELL COMPLETION DATA:			
(1) diameter (inches) 2"			
(2) total depth (feet) 84'			
(3) static water level (feet) 50 below top of ground.			
(4) casing (material) (depth) 84'			
2" if telescope see back. (size)			
(5) screen (length) (depth to top) 3'			
2 1/2" S.S. (size) (material)			
(6) pump 3/4 (HP) 7 (yield gpm)			
(type power)			
(7) electric log (yes or no)			
(organization running log)			
(8) how well bottom plugged BN			
DRILLERS REMARKS:			


CODED

FEB 5 - 1970

MISS. BD. OF
WATER COM.

If well telescopes please sketch and show depths.

GROUND LEVEL

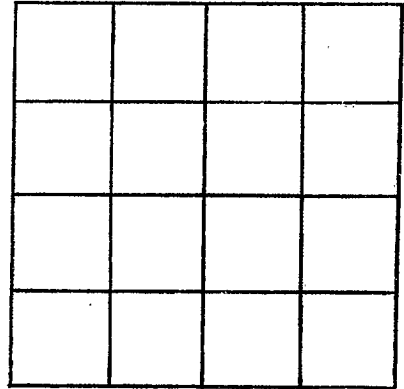

SECTION _____

Please indicate well location X.

ADDITIONAL INFORMATION

If more than one screen, show locations of each on sketch.