

CODED

MISSISSIPPI
BOARD OF WATER COMMISSIONERS
416 North State Street
Jackson, Mississippi 39201

WATER WELL DRILLERS LOG

MARION
H 16
12-69

DECEMBER 1969 E.B. Sheward Marion
date well completed firm name county well located

LANDOWNER:	description of formations encountered	from	to
J.C. Stringer Columbia, Miss. (mailing address)	RED CLAY	0	26'
	RED SANDY SAND	26	80'
	SAND & GRAVEL	80'	119'
	GRAY CLAY BASE	0	
WELL LOCATION: sec. <u>7</u> T. <u>4</u> N. R. <u>17</u> E. 7 miles NE of Columbia (distance) (direction) (nearest town)			
WELL PURPOSE: (home, irrigation, municipal, industrial)			
WELL COMPLETION DATA: (1) diameter (inches) <u>4"</u> (2) total depth (feet) <u>119</u> (3) static water level (feet) <u>85</u> below top of ground. (4) casing <u>Plastic, 119'</u> (material) (depth) <u>4"</u> if telescope see back. (size) (5) screen <u>10'</u> (length) (depth to top) <u>4"</u> S.S. (size) (material) (6) pump <u>1</u> (HP) <u>25</u> (yield gpm) (type power) (7) electric log <u>(yes or no)</u> (organization running log) (8) how well bottom plugged <u>BN</u>			
DRILLERS REMARKS:			


CODED

FEB 5 - 1970

REC'D
MISS. DEP.
OF AGRICULTURE

If well telescopes please sketch and show depths.

GROUND LEVEL

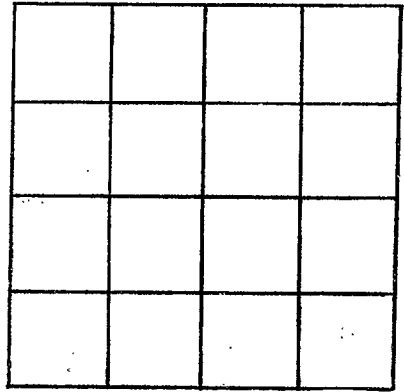

SECTION _____

Please indicate well location X.

ADDITIONAL INFORMATION

A series of horizontal lines for entering additional information.

If more than one screen, show locations of each on sketch.