

MARION
H 17
1-1-70

MISSISSIPPI
BOARD OF WATER COMMISSIONERS
416 North State Street
Jackson, Mississippi 39201

CODED

WATER WELL DRILLERS LOG

JAN 1 1970 E.B. Sheppard Marion
date well completed firm name county well located

LANDOWNER: Elmer Buelord
Rt. 1
Columbia, Miss.
(mailing address)

description of formations encountered	from	to
STICKY RED CLAY	0	140
VERY FINE SAND	140	50
SANDY GRAY CLAY	50	70
SAND & PEACHWOOD	70	87

WELL LOCATION:
sec. 5 T 4 N R 17 E
9 miles N.E. of Columbia
(distance) (direction) (nearest town)

WELL PURPOSE:
(home, irrigation, municipal, industrial)

- WELL COMPLETION DATA:
- (1) diameter (inches) 2 1/2"
 - (2) total depth (feet) 87'
 - (3) static water level (feet) 48' below above top of ground.
 - (4) casing (material) (depth) Plastic, 87'
 - 2" if telescope see back. (size)
 - (5) screen 3' (length) (depth to top)
 - 2 1/2" S.S. (size) (material)
 - (6) pump 3/4 (HP) 9 (yield gpm)
 - (type power)
 - (7) electric log (yes or no)
 - (organization running log)
 - (8) how well bottom plugged BW

CODED


FEB 5 1970

MISS. BD. OF
WATER COMM.

DRILLERS REMARKS:

If well telescopes please sketch and show depths.

GROUND LEVEL

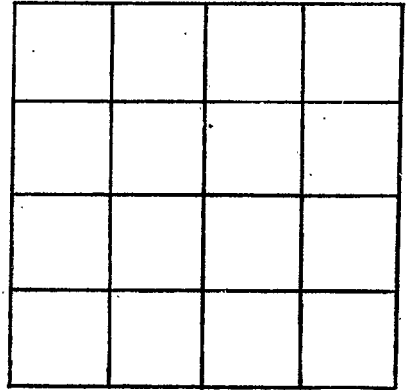

SECTION _____

Please indicate well location X.

ADDITIONAL INFORMATION

If more than one screen, show locations of each on sketch.