

Marion
 H 18
 3-70

MISSISSIPPI
 BOARD OF WATER COMMISSIONERS
 416 North State Street
 Jackson, Mississippi 39201

CODED

WATER WELL DRILLERS LOG

March 1970 E.B. Sheppard Marion
 date well completed firm name county well located


LANDOWNER:	description of formations encountered	from	to
L.H. Sheppard	RED SANDY CLAY	0	85
Columbus, Miss.	GRAY CLAY	85	105
(mailing address)	RED CLAY		
WELL LOCATION:	FIBR CLAY	105	112
sec 31 T 4 N 17 E 136	GRAY CLAY	112	135
4 miles E of Columbia	GRAY SH FINE SAND & CLAY	135	150
(distance) (direction) (nearest town)	COARSE WHITE SAND & FEA-G.	150	174
WELL PURPOSE:			
(home) irrigation, municipal, industrial			
WELL COMPLETION DATA:			
(1) diameter (inches) 2"			
(2) total depth (feet) 174			
(3) static water level (feet) 90 below above of ground.			
(4) casing (material) Plastic (depth) 171			
2" (size) if telescope see back.			
(5) screen 3' (length) (depth to top)			
2" (size) S.S. (material)			
(6) pump 1 1/2 (HP) 8 (yield gpm)			
E (type power)			
(7) electric log (yes or no)			
(organization running log)			
(8) how well bottom plugged BWV			
DRILLERS REMARKS:			

MAY 26 1970

MISS. BD. OF
 WATER COMM.

If well telescopes please sketch and show depths.

GROUND LEVEL

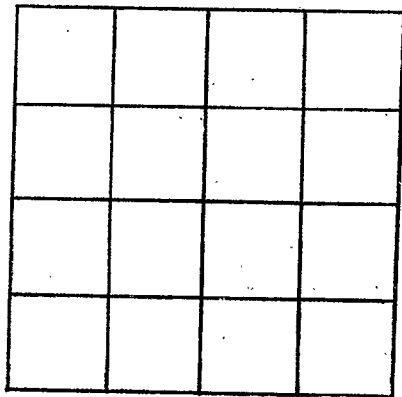

SECTION _____

Please indicate well location X.

ADDITIONAL INFORMATION

A series of horizontal lines for recording additional information.

If more than one screen, show locations of each on sketch.