

MISSISSIPPI
BOARD OF WATER COMMISSIONERS
416 North State Street
Jackson, Mississippi 39201

CODED

WATER WELL DRILLERS LOG

MARION
H 19
4-70

APRIL 1970 E.B. SHERRARD MARION
date well completed firm name county well located

LANDOWNER: THEOLA WATTS
Rt 2 - Sumrall, Miss.
(mailing address)

description of formations encountered	from	to
RIED SANDY CLAY	0	30
GRAVEL CLAY	30	90
FINE SAND	90	130
PEA GRAVEL	130	153

WELL LOCATION:
sec. 12 T 4 N R 17 E
11 miles NE of Columbia
(distance) (direction) (nearest town)

WELL PURPOSE:
(Home, irrigation, municipal, industrial)

WELL COMPLETION DATA:

(1) diameter (inches) 2"
(2) total depth (feet) 153
(3) static water level (feet) 110 below top of ground.
(4) casing Plastic, 150 (material) (depth)
2" (size) if telescope see back.
(5) screen 3' (length) (depth to top)
2" (size) SS. (material)
(6) pump 1 1/2 (HP) 7 (yield gpm)
E (type power)
(7) electric log (yes or no)
(organization running log)
(8) how well bottom plugged B/W


CODED

AUG 18 1970

DRILLERS REMARKS:

If well telescopes please sketch and show depths.

GROUND LEVEL

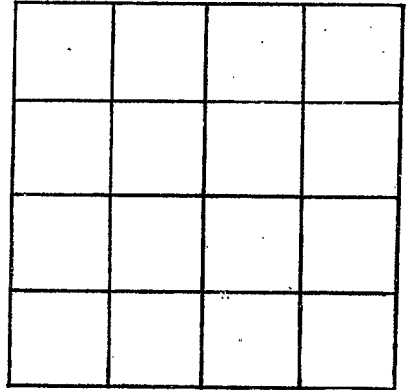

SECTION _____

Please indicate well location X.

ADDITIONAL INFORMATION

If more than one screen,
show locations of each on sketch.