

MARION
H 20
9-70

MISSISSIPPI
BOARD OF WATER COMMISSIONERS
416 North State Street
Jackson, Mississippi 39201
WATER WELL DRILLERS LOG

CODED

SEPT. 19 70 F. B. SHERRARD MARION
date well completed firm name county well located

LANDOWNER:

SHERMAN STRINGER
Columbia, Miss.
(mailing address)

description of formations encountered

from to

RED SANDY CLAY GRAVEL 0 70'
SANDY GRAVEL 70 123'

WELL LOCATION:

sec. 17 T. 4 N R. 17 E
7 miles NE of Columbia
(distance) (direction) (nearest town)

WELL PURPOSE:

(home) irrigation, municipal, industrial

WELL COMPLETION DATA:

- (1) diameter (inches) 4"
- (2) total depth (feet) 123'
- (3) static water level (feet) 76 below top of ground.
- (4) casing PL, 113 (material) (depth), 4" (size) if telescope see back.
- (5) screen 10' (length) (depth to top), 4" (size), Plastic (material)
- (6) pump 1-Sub, 25 (HP) (yield gpm), E (type power)
- (7) electric log (yes or no) (organization running log)
- (8) how well bottom plugged BWP

CODED


OCT 19 1970

MISS. B. OF WATER

DRILLERS REMARKS:

If well telescopes please sketch and show depths.

GROUND LEVEL

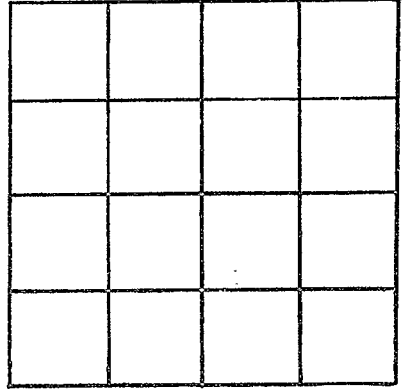

SECTION _____

Please indicate well location X.

ADDITIONAL INFORMATION

If more than one screen, show locations of each on sketch.