

MARION  
 A 21  
 8-70

MISSISSIPPI  
 BOARD OF WATER COMMISSIONERS  
 416 North State Street  
 Jackson, Mississippi 39201

CODED

WATER WELL DRILLERS LOG

AUGUST 1970 E.B. SKERRARD MARION  
 date well completed firm name county well located

LANDOWNER:	description of formations encountered	from	to
DAVID HENDRICKS COLUMBIA, Miss. (mailing address)	GRAY CLAY FINE POWDERED SAND WITH GRAY STREAKS CLAY	0	68
WELL LOCATION: sec. 4 T 4 N R 17 E 9 miles ENE of COLUMBIA (distance) (direction) (nearest town)	VERY COARSE SAND & PEA GRAVEL	68	120
WELL PURPOSE: (home, irrigation, municipal, industrial)			
WELL COMPLETION DATA:			
(1) diameter (inches) 2"	CODED		
(2) total depth (feet) 143			
(3) static water level (feet) 79 below top of ground.			
(4) casing PL 140 (material) (depth) 2" (size) if telescope see back.			
(5) screen 3' (length) (depth to top) 2" (size) S.S. (material)			
(6) pump 1/2 8 (HP) (yield gpm) E (type power)			
(7) electric log (yes or no)			
(8) how well bottom plugged BNV			


OCT 19 1970

MISS. RD. OF  
 WATER COM.

DRILLERS REMARKS:

If well telescopes please sketch and show depths.

GROUND LEVEL

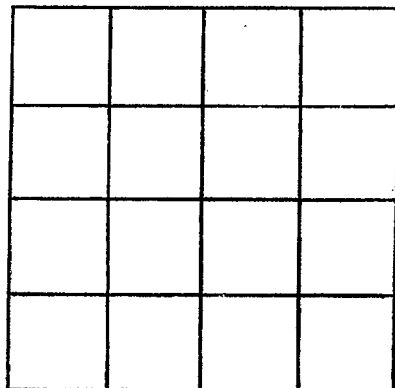

SECTION \_\_\_\_\_

Please indicate well location X.

ADDITIONAL INFORMATION

If more than one screen, show locations of each on sketch.