

MARION

H22

9-70

MISSISSIPPI BOARD OF WATER COMMISSIONERS

416 North State Street

Jackson, Mississippi 39201

CODED

WATER WELL DRILLERS LOG

SEPT.

1970

F. B. SHERDARD

MARION

date well completed

firm name

county well located

LANDOWNER:

JOHN E. PARKER

COLUMBIA, MISS.
(mailing address)

description of formations encountered

from to

BLUE CLAY	0	105
FINE SAND	105	135
COARSE WHITE SAND & PEA GRAVEL	135	148

WELL LOCATION:

sec 25 T. 4 N R. 17 E
 (distance) (direction) (nearest town)

10 miles E of COLUMBIA

WELL PURPOSE:

(home) Irrigation, municipal, industrial

WELL COMPLETION DATA:

- (1) diameter (inches) 2"
- (2) total depth (feet) 148
- (3) static water level (feet) 32 below above top of ground.
- (4) casing PL, 145,
(material) (depth)
2" if telescope see back.
(size)
- (5) screen 3',
(length) (depth to top)
2", S.S.
(size) (material)
- (6) pump 3/4, 8
(HP) (yield gpm)
E
(type power)
- (7) electric log (yes or no)
(organization running log)
- (8) how well bottom plugged BWV

CODED


OCT 19 1970

MISS. BD. OF WATER COMM.

DRILLERS REMARKS:

If well telescopes please sketch and show depths.

GROUND LEVEL

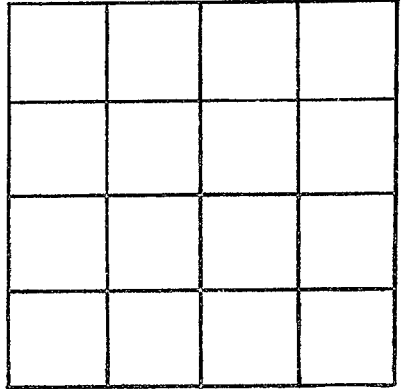

SECTION _____

Please indicate well location X.

ADDITIONAL INFORMATION

If more than one screen,
show locations of each on sketch.