

MARION
25
11-70

MISSISSIPPI
BOARD OF WATER COMMISSIONERS
416 North State Street
Jackson, Mississippi 39201

CODED

WATER WELL DRILLERS LOG

Nov. 1970 E. B. SHERRARD MARION
date well completed firm name county well located

LANDOWNER:
SHELTON STRINGER
COLUMBIA, MISS.
(mailing address)

description of formations encountered	from	to
GRAY + BLUISH CLAY	0'	150'
COARSE - COARSE GRA. & SAND	150'	160'
BLUE CLAY BASE		

WELL LOCATION:
sec 35 T 4 N R 17 E
S W
10 miles E of COLUMBIA
(distance) (direction) (nearest town)

WELL PURPOSE:
(home) irrigation, municipal, industrial

WELL COMPLETION DATA:

- (1) diameter (inches) 2"
- (2) total depth (feet) 160
- (3) static water level (feet) 58 ^{below} _{above} top of ground.
- (4) casing PL. 155' (material) (depth)
2" (size) if telescope see back.
- (5) screen 3' (length) (depth to top)
2" (size) PL. (material)
- (6) pump 1-HP 8 (HP) (yield gpm)
E (type power)
- (7) electric log (yes or no)
- (organization running log)
- (8) how well bottom plugged B.W.V

CODED


FEB 7 1971

MISS. DEP. OF
WATER RESOURCES

DRILLERS REMARKS:

If well telescopes please sketch and show depths.

GROUND LEVEL

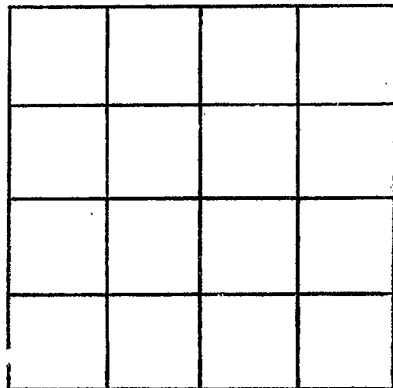

SECTION _____

Please indicate well location X.

ADDITIONAL INFORMATION

If more than one screen,
show locations of each on sketch.