

Marion
H-27
6-71

MISSISSIPPI
BOARD OF WATER COMMISSIONERS
416 North State Street
Jackson, Mississippi 39201

WATER WELL DRILLERS LOG

CODED

JUNE 1971
date well completed

E. B. SHEPARD
firm name

Marion
county well located

LANDOWNER:

GEORGE SINGLEY
COLUMBIA
(mailing address)

description of formations
encountered

	from	to
LOOSE RED SANDY CLAY	0	50'
COARSE SAND + RED GRAVEL	50	78'

WELL LOCATION:

sec. 29 T 4 N R 17 E
6 miles ENE of Columbia
(distance) (direction) (nearest town)

WELL PURPOSE:

(home) irrigation, municipal, industrial

WELL COMPLETION DATA:

- (1) diameter (inches) 3"
(2) total depth (feet) 78
(3) static water level (feet) 55 below top of ground.
(4) casing PL 72' (material) (depth)
3" (size) if telescope see back.
(5) screen 6' (length) (depth to top)
3" PL (size) (material)
(6) pump 1/2 (HP) 10 (yield gpm)
E (type power)
(7) electric log (yes or no)
(organization running log)
(8) how well bottom plugged BWV

CODED


SEP 15 1971

MISS. BD. OF
WATER COMM.

DRILLERS REMARKS:

If well telescopes please sketch and show depths.

GROUND LEVEL

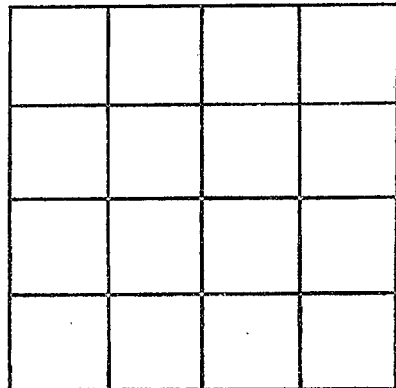

SECTION _____

Please indicate well location X.

ADDITIONAL INFORMATION

If more than one screen, show locations of each on sketch.