

MARION
H 28
3-71

MISSISSIPPI
BOARD OF WATER COMMISSIONERS
416 North State Street
Jackson, Mississippi 39201

CODED

WATER WELL DRILLERS LOG

March 1971 E. B. SHERPARD Marion
date well completed firm name county well located

LANDOWNER:
LLOYD SINGLEY
Columbia, Miss
(mailing address)

description of formations encountered	from	to
SANDY BED	0	20'
CLAY		
SAND & GRAVEL	20'	87'

WELL LOCATION:
sec 29 T 4 N R 17 E
5 1/2 miles NE of Columbia
(distance) (direction) (nearest town)

WELL PURPOSE:
(home) irrigation, municipal, industrial

- WELL COMPLETION DATA:
- (1) diameter (inches) 3"
 - (2) total depth (feet) 87
 - (3) static water level (feet) 55 below above top of ground.
 - (4) casing SPL 81 (material) (depth)
3" (size) if telescope see back.
 - (5) screen 6' (length) (depth to top)
3" (size) PL (material)
 - (6) pump 1/2 (HP) 10 (yield gpm)
E. (type power)
 - (7) electric log (yes or no)
 - (organization running log)
 - (8) how well bottom plugged BwV

CODED


MAY 27 1971

DRILLERS REMARKS:

MISS. DE. OF
WATER

If well telescopes please sketch and show depths.

GROUND LEVEL

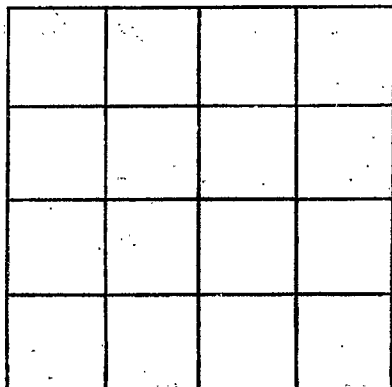

SECTION _____

Please indicate well location X.

ADDITIONAL INFORMATION

If more than one screen,
show locations of each on sketch.