

MARION
H-29
8-4-71

MISSISSIPPI
BOARD OF WATER COMMISSIONERS
416 North State Street
Jackson, Mississippi 39201

CODED

WATER WELL DRILLERS LOG

8-4-71 date well completed
Dean Drilled Well Service firm name
Marion county well located

LANDOWNER:
Ray Brown
Route 1 Columbia, Miss.
(mailing address)

description of formations encountered	from	to
<u>top soil</u>	<u>0</u>	<u>1</u>
<u>Chalk</u>	<u>1</u>	<u>46</u>
<u>sand</u>	<u>46</u>	<u>105</u>

WELL LOCATION:
sec. 8 T. 4 (N) R. 17 (E)
6 miles NE of Columbia
(distance) (direction) (nearest town)

WELL PURPOSE: Home Use
(home, irrigation, municipal, industrial)

- WELL COMPLETION DATA:
- (1) diameter (inches) 4"
 - (2) total depth (feet) 105'
 - (3) static water level (feet) 60' below top of ground.
 - (4) casing Galv. 100'
(material) (depth)
____ (size) if telescope see back.
 - (5) screen 5' 100'
(length) (depth to top)
4" S.S.
(size) (material)
 - (6) pump 1 _____
(HP) (yield gpm)
____ (type power)
 - (7) electric log _____
(yes or no)
____ (organization running log)
 - (8) how well bottom plugged _____

CODED


AUG 10 1971

MISS. BD. OF
WATER COMM.

DRILLERS REMARKS:

If well telescopes please sketch and show depths.

GROUND LEVEL

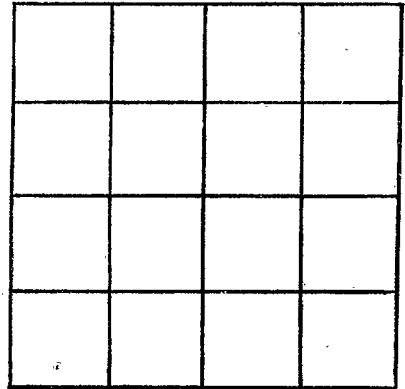

SECTION _____

Please indicate well location X.

ADDITIONAL INFORMATION

If more than one screen, show locations of each on sketch.