

MARION

H 30

2-73

MISSISSIPPI
 BOARD OF WATER COMMISSIONERS
 416 North State Street
 Jackson, Mississippi 39201

CODED

WATER WELL DRILLERS LOG

Feb 1973 E. B. Sherrard Marion
 date well completed firm name county well located

LANDOWNER:

Jerry Simmons
 Columbia Miss
 (mailing address)

description of formations encountered

description of formations encountered	from	to
CLAY SANDY	0	60
CLAY SANDY + GRAVEL	60	120

WELL LOCATION:

sec 20 T 4 N R 17 E
 S W
 5 miles E Columbia
 (distance) (direction) (nearest town)

WELL PURPOSE:

(home, irrigation, municipal, industrial)

WELL COMPLETION DATA:

- (1) diameter (inches) 4"
- (2) total depth (feet) 120'
- (3) static water level (feet) 60' below top of ground.
- (4) casing pl. 110' (depth)
 4" (size) if telescope see back.
- (5) screen 10' (length) (depth to top)
 4" (size) pl. (material)
- (6) pump 1 (HP) 30 (yield gpm)
 E (type power)
- (7) electric log (yes or no)

(organization running log)


(8) how well bottom plugged BWV

DRILLERS REMARKS:

CODED

If well telescopes please sketch and show depths.

GROUND LEVEL

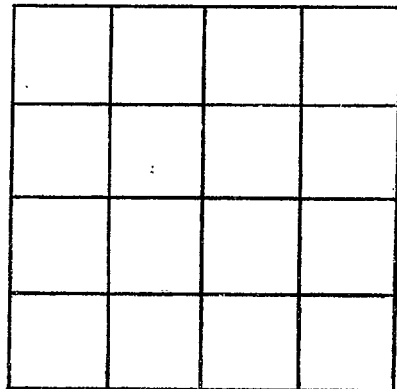

SECTION _____

Please indicate well location X.

ADDITIONAL INFORMATION

If more than one screen, show locations of each on sketch.