

Marion
H 33
4/75

MISSISSIPPI
BOARD OF WATER COMMISSIONERS
416 North State Street
Jackson, Mississippi 39201

CODED

WATER WELL DRILLERS LOG

April 1975 E.B. Sheppard Marion
date well completed firm name county well located

LANDOWNER:
Ouis Stringer
Columbia, Ms.
(mailing address)

description of formations encountered	from	to
GRAY CLAY	0	130
COARSE SAND	130	168

WELL LOCATION:
sec 22 T 4 N R 17 E
8 miles E of Columbia
(distance) (direction) (nearest town)

WELL PURPOSE:
(home irrigation, municipal, industrial)


- WELL COMPLETION DATA:
- (1) diameter (inches) 2"
 - (2) total depth (feet) 168'
 - (3) static water level (feet) 75' below top of ground.
 - (4) casing pl. 163' (material) (depth)
2" (size) if telescope see back.
 - (5) screen 5' (length) (depth to top)
2" (size) pl. (material)
 - (6) pump 1 (HP) 7 (yield gpm)
E (type power)
 - (7) electric log (yes or no)
 - (8) how well bottom plugged BWV

DRILLERS REMARKS:

RECEIVED
MAY - 8 1975

If well telescopes please sketch and show depths.

GROUND LEVEL

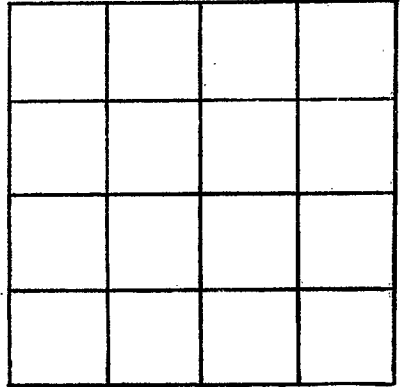

SECTION _____

Please indicate well location X.

ADDITIONAL INFORMATION

If more than one screen, show locations of each on sketch.