

Marion
H 34
4/75

MISSISSIPPI
BOARD OF WATER COMMISSIONERS
416 North State Street
Jackson, Mississippi 39201

WATER WELL DRILLERS LOG

CODED

April 25 1975 E.B. Sheppard Marion
date well completed firm name county well located

LANDOWNER:
Ervin Stringer
Columbia, Ms.
(mailing address)

description of formations encountered	from	to
BLUE & GRAY CLAY	0	100
FINE GRAY SAND	100	110
COARSE DIAG & WHITE SAND	110	122

WELL LOCATION:
sec 35 T 4 N R 17 E
S 8 miles E of Columbia
(distance) (direction) (nearest town)

WELL PURPOSE:
(home, irrigation, municipal, industrial)

WELL COMPLETION DATA:

(1) diameter (inches) 2"

(2) total depth (feet) 122'

(3) static water level (feet) 40' ^{below} _{above} top of ground.

(4) casing pl. 117'
(material) (depth)
2" if telescope see back.
(size)

(5) screen 5'
(length) (depth to top)
2" pl.
(size) (material)

(6) pump 1 7
(HP) (yield gpm)
E
(type power)

(7) electric log (yes or no) no

(organization running log)

(8) how well bottom plugged BWV

DRILLERS REMARKS:


RECEIVED
RECEIVED

MAY - 8 1975

MISS. RD. OF WATER COMMISSIONERS

If well telescopes please sketch and show depths.

GROUND LEVEL

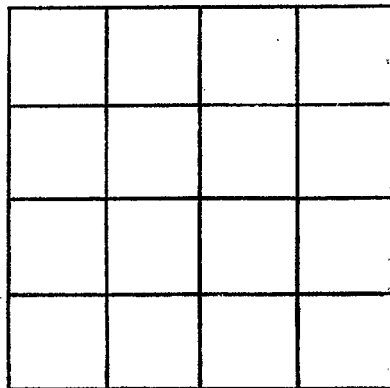

SECTION _____

Please indicate well location X.

ADDITIONAL INFORMATION

If more than one screen, show locations of each on sketch.