

MARION  
H35  
4/77 H  
Flag # 90

MISSISSIPPI  
BOARD OF WATER COMMISSIONERS CODED  
416 North State Street  
Jackson, Mississippi 39201

WATER WELL DRILLERS LOG

date well completed 19 77 firm name Green Drilling Service MARION county well located

LANDOWNER: HIGHWAY 28  
EAST WATER ASSOCI  
WELL NO. 2  
(mailing address)  
WELL LOCATION: NE 1/4 NW 1/4  
sec. 32 T 4 N R 17 E  
(distance) miles of (direction) (nearest town)

WELL PURPOSE:  
(home, irrigation, municipal, industrial)

- WELL COMPLETION DATA:
- (1) diameter (inches) 8 5/8"
  - (2) total depth (feet) 922 Ft
  - (3) static water level (feet) 183 (below above top of ground)
  - (4) casing steel 875 Ft (material) (depth)  
8 5/8" (size) if telescope see back.
  - (5) screen 40 Ft 882 (length) (depth to top)  
6" 304 S.S. (.008) (size) (material)
  - (6) pump 20 167 (HP) (yield gpm)  
Elect. (type power)
  - (7) electric log yes (yes or no)  
MOS (organization running log)
  - (8) how well bottom plugged BACK  
LARGE VALVE

description of formations encountered	from	to
TOP SOIL	0	3
Red Sandy Clay	3	28
SAND	28	114
SAND + CLAY STRATA	114	130
CLAY	135	190
SAND coarse	190	290
CLAY 1	290	424
SAND w. CLAY STRATA	424	580
SAND	585	744
CLAY	744	870
SAND, Med.	870	950
CLAY + ROCKS	950	982

COULD

Miss. Board of Water Comm.

MAR 23 1979


RECEIVED

DRILLERS REMARKS:

2

If well telescopes please sketch and show depths.

GROUND LEVEL

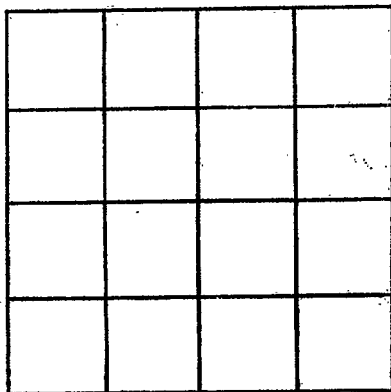

SECTION \_\_\_\_\_

Please indicate well location X.

ADDITIONAL INFORMATION

If more than one screen, show locations of each on sketch.