

MARION  
H 36  
3/7/78

MISSISSIPPI  
BOARD OF WATER COMMISSIONERS  
416 North State Street  
Jackson, Mississippi 39201

CODED

WATER WELL DRILLERS LOG

Criner Drilling Service

Marion Co.

3/7/78  
date well completed

firm name

county well located

LANDOWNER: Sun Oil Co.  
M.H. Patterson #1

description of formations encountered

from to

Sand Clay Gravel	0	42
Stratified Sand Clay	42	105
Sand, Clay, gravel	105	121
Sand	121	210
Sand, Pea Gravel	210	252
Sand Clay	252	273
Clay Stratified w/ Sand	273	399
Clay w/ Sand on Bottom	399	441
3" top clay then Sand	441	462
7' Sand	462	504
Stratified Sand & Clay	504	525

(mailing address)

WELL LOCATION:

sec 18 T 4 N R 17 E  
1980 N x 1980 W of SE/4th of Columbia  
(distance) (direction) (nearest town)

WELL PURPOSE:

(home, irrigation, municipal, industrial)

WELL COMPLETION DATA:

- diameter (inches) 3"
- total depth (feet) 525
- static water level (feet) 130 below top of ground
- casing steel 509 (material) (depth)  
3" if telescope see back. (size)
- screen 42' 467 (length) (depth to tap)  
3" Perforated Pipe (size) (material)
- pump 80 (HP) (yield gpm)  
AC (type power)
- electric log NO (yes or no)
- organization running log
- how well bottom plugged Orange Peel


DRILLERS REMARKS:

RECEIVED  
MAR 30 1978

MISS. BD. OF WATER COMMISSIONERS

If well telescopes please sketch and show depths.

GROUND LEVEL

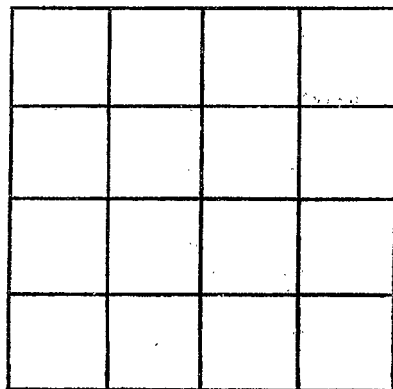

SECTION \_\_\_\_\_

Please indicate well location X.

ADDITIONAL INFORMATION

If more than one screen, show locations of each on sketch.