

MARION
H37
2-15-79

MISSISSIPPI
BOARD OF WATER COMMISSIONERS
416 North State Street
Jackson, Mississippi 39201

CODED

WATER WELL DRILLERS LOG

2-15 1979 Griner Drilling Marion
date well completed firm name county well located

LANDOWNER:
SUN GAS
P.O. Box 3308
Lafayette, La 70501
(mailing address)

description of formations encountered	from	to
Sand-gravel	0	231
Chalk	231	454
SAND	454	504

WELL LOCATION: 1500'S + 1659' W
sec. 19 T-4 N R-17 E of Hwy 44 NE/CO of Hwy 5 miles North of Columbia (distance) (direction) (nearest town)

WELL PURPOSE: oil field
(home, irrigation, municipal, industrial)

CODED

- WELL COMPLETION DATA:
- (1) diameter (inches) 3"
 - (2) total depth (feet) 504'
 - (3) static water level (feet) 150' ^{below} above top of ground.
 - (4) casing steel 504' (material) (depth)
3" (size) if telescope see back.
 - (5) screen 42' 46 2' (length) (depth to top)
3" perforated (size) (material)
 - (6) pump AC (HP) 70 (yield gpm)
(type power)
 - (7) electric log (yes or no)
(organization running log)

(8) how well bottom plugged orange
peel

DRILLERS REMARKS:


Miss. Board of Water Comm.

FEB 26 1979

RECEIVED

If well telescopes please sketch and show depths.

GROUND LEVEL

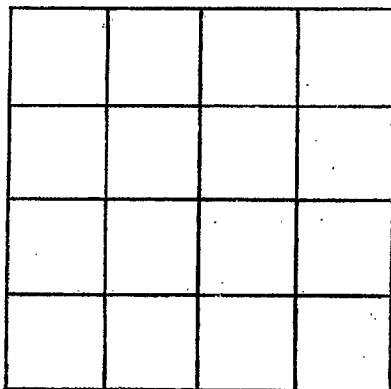

SECTION _____

Please indicate well location X.

ADDITIONAL INFORMATION

If more than one screen, show locations of each on sketch.