

MARION
#-38
4-19-80

MISSISSIPPI
BOARD OF WATER COMMISSIONERS
416 North State Street
Jackson, Mississippi 39201

CODED

WATER WELL DRILLERS LOG

4-19-80 Griner Drilling Marion
date well completed firm name county well located

LANDOWNER: Florida Gas + Exploration
1444 Capital Towers
Jackson, MS 39205
(mailing address)

description of formations encountered	from	to
clay	0	252
sand	252	315
clay	315	357
clay + sand	357	399
sand + clay	399	420
clay	420	500

WELL LOCATION: 1650' S + 2300' W
sec. 4 T. 40 N. R. 17 E. of
Improve (distance) (direction) (nearest town)
No! Morris

WELL PURPOSE: oil field supply
(home, irrigation, municipal, industrial)

- WELL COMPLETION DATA:
- (1) diameter (inches) 3"
 - (2) total depth (feet) 520'
 - (3) static water level (feet) 100' (below top of ground)
 - (4) casing (material) steel (depth) 315'
3" (size) if telescope see back.
 - (5) screen (length) 42' (depth to top) 273'
3" (size) (material) perforated
 - (6) pump (HP) AC (yield gpm) 60
(type power)
 - (7) electric log (yes or no)

(8) how well bottom plugged orange peel
(organization running log)

DRILLERS REMARKS:


DEPT. OF NATURAL RESOURCES
BUREAU OF LAND & WATER RESOURCES

APR 30 1980

RECEIVED

If well telescopes please sketch and show depths.

GROUND LEVEL

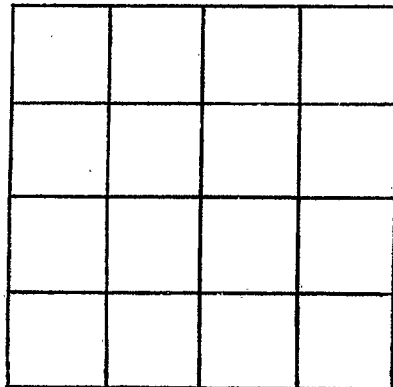

SECTION _____

Please indicate well location X.

ADDITIONAL INFORMATION

If more than one screen, show locations of each on sketch.