

MARION
H 39
5-23-80

MISSISSIPPI
BOARD OF WATER COMMISSIONERS
416 North State Street
Jackson, Mississippi 39201

CODED

WATER WELL DRILLERS LOG

5-23-80 Griner Drilling Marion
date well completed firm name county well located

LANDOWNER:
Sun Gas Company
P.O. Box 3308
Lafayette, La 70502
(mailing address)

description of formations encountered	from	to
clay, top sand	0	56
clay + sand	56	140
sand	140	203
sand + gravel	203	245
clay	245	371
sand + clay	371	392
clay	392	455
sand	455	539

WELL LOCATION: 1500' N + 1500' E
NO 1 SE 1/4 T 40 N R 17 E of
Raybon Improve SW/CO
17-11 miles (distance) of (direction) (nearest town)

WELL PURPOSE: oil field supply
(home, irrigation, municipal, industrial)

WELL COMPLETION DATA:
(1) diameter (inches) 3"
(2) total depth (feet) 539'
(3) static water level (feet) 65' (below top of ground)
(4) casing steel 539' (material) (depth)
3" (size) if telescope see back.
(5) screen 42' 499' (length) (depth to top)
3" perforated (size) (material)
(6) pump 75 (HP) (yield gpm)
AC (type power)
(7) electric log (yes or no)
(organization running log)

CODED

DEPT. OF NATURAL RESOURCES
BUREAU OF LAND & WATER RESOURCES

MAY 29 1980


RECEIVED

(8) how well bottom plugged
peel orange

DRILLERS REMARKS:

If well telescopes please sketch and show depths.

GROUND LEVEL

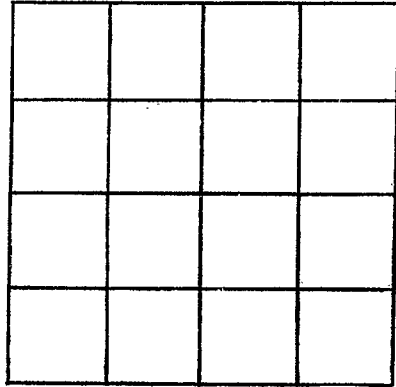

SECTION _____

Please indicate well location X.

ADDITIONAL INFORMATION

A series of horizontal lines for writing additional information, starting below the 'ADDITIONAL INFORMATION' header and extending to the bottom of the page.

If more than one screen, show locations of each on sketch.