

MARZDAS
 H-40
 11/13/80

MISSISSIPPI
 BOARD OF WATER COMMISSIONERS
 416 North State Street
 Jackson, Mississippi 39201

CODED

WATER WELL DRILLERS LOG

Griner Drilling
 Service, Inc

Marion

date well completed

firm name

county well located

LANDOWNER:

Sun Gas Company
 P. O. Box 3308
 Lafayette, La. 70504
 (mailing address)

description of formations
 encountered

from

to

sand, pea
 gravel

0 70

clay, sand

70 420

sand, pea
 gravel

420 504

CODED

WELL LOCATION: 1500' S + 1500' E

no 1
 Sec 20, T 40 N, R 17 E of
 Beck Unit
 20-6
 Improve
 (distance) (direction) (nearest town)

WELL PURPOSE: Oil Field
 (home, irrigation, municipal, industrial)
 supply

WELL COMPLETION DATA:

- (1) diameter (inches) 4"
- (2) total depth (feet) 504'
- (3) static water level (feet) 100' ^{below} _{above} top of ground.
- (4) casing steel, 504'
 (material) (depth)
 4" If telescope see back.
 (size)
- (5) screen 42', 462'
 (length) (depth to top)
 4", perforated
 (size) (material)
- (6) pump - 85
 (HP) (yield gpm)
 ac
 (type power)
- (7) electric log (yes or no)

(organization running log)

(8) how well bottom plugged orange
 pebb

DRILLERS REMARKS:


DEPT. OF NATURAL RESOURCES
 BUREAU OF LAND & WATER RESOURCES

NOV 25 1980

RECEIVED

If well telescopes please sketch and show depths.

GROUND LEVEL

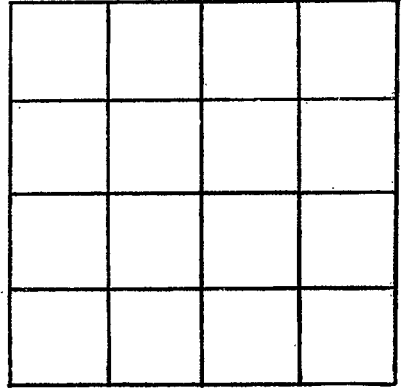

SECTION _____

Please indicate well location X.

ADDITIONAL INFORMATION

If more than one screen, show locations of each on sketch.