

MISSISSIPPI DEPARTMENT OF NATURAL RESOURCES

Bureau of Land and Water Resources

Southport Mall

P.O. Box 10631

Jackson, Mississippi 39209

CODED

WATER WELL DRILLERS LOG

Griner Drilling Service, Inc.

Marion

Marion
H 41
9-26-81

date well completed *9-26-81*

firm name

county well located

LANDOWNER:	description of formations encountered	from	to
<i>McKae Oil Company</i> <i>800 Dresser Towers</i> <i>Houston, Texas 77002</i> (mailing address)	<i>sand, gravel</i>	<i>0</i>	<i>273</i>
WELL LOCATION: <i>1200' S + 1100' E</i>	<i>chalk</i>	<i>273</i>	<i>483</i>
No. sec. <i>16</i> T. <i>4</i> N. R. <i>17</i> E. NW/4	<i>streaked</i>	<i>483</i>	<i>546</i>
Bd. of <i>Education</i> Improve Field	<i>sand, gravel</i>	<i>546</i>	<i>610</i>
WELL PURPOSE: <i>oil field supply</i> (home, irrigation, municipal, industrial)			
WELL COMPLETION DATA:			
(1) diameter (inches) <i>3"</i>			
(2) total depth (feet) <i>610'</i>			
(3) static water level (feet) <i>100'</i> ^(66' low) above top of ground.			
(4) casing <i>steel</i> , <i>610'</i> (material) (depth)			
<i>3"</i> (size) if telescope see back.			
(5) screen <i>42'</i> , <i>568'</i> (length) (depth to top)			
<i>3"</i> , <i>perforated</i> (size) (material)			
(6) pump <i>—</i> , <i>75-90</i> (HP) (yield gpm)			
<i>RC</i> (type power)			
(7) electric log <i>—</i> (yes or no)			
(organization running log)			
(8) how well bottom plugged <i>orange</i>			
<i>peel</i>			
DRILLERS REMARKS:			

CODED


DEPT. OF NATURAL RESOURCES
BUREAU OF LAND & WATER RESOURCES

OCT 20 1981

RECEIVED

If well telescopes please sketch and show depths.

GROUND LEVEL

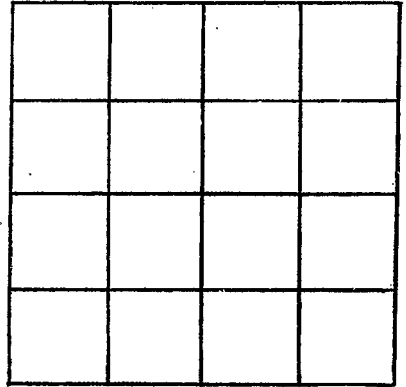

SECTION _____

Please indicate well location X.

ADDITIONAL INFORMATION

If more than one screen, show locations of each on sketch.