

MISSISSIPPI DEPARTMENT OF NATURAL RESOURCES

Bureau of Land and Water Resources

Southport Mall

P.O. Box 10631

Jackson, Mississippi 39209

WATER WELL DRILLERS LOG

CODED

Griner Drilling Service, Inc.

Marion

MARION
H 42
9-26-81

date well completed

firm name

county well located

LANDOWNER:

McRae Oil Corporation
800 Dresser Towers
Houston, Texas 77002

(mailing address)

description of formations encountered

from

to

Sand, gravel

0 273

chalk

273 483

WELL LOCATION: *1200' S of 1100' E*

sec. *16* T. *4* N. R. *17* E. *North* / *Co.*

Stratified

483 546

No. 1 of *Improve* *Field*
Bd of *Edwards* *W* *W*
(distance) (direction) (nearest town)

Sand, gravel

546 610

WELL PURPOSE: *oil field supply*
(home, irrigation, municipal, industrial)

WELL COMPLETION DATA:

(1) diameter (inches) *3"*

(2) total depth (feet) *610'*

(3) static water level (feet) *150'* *below* *above*
top of ground.

(4) casing *steel*, *609'*
(material) (depth)

3"
(size) If telescope see back.

(5) screen *42'*, *567'*
(length) (depth to top)

3", *perforated*
(size) (material)

(6) pump *—*, *100*
(HP) (yield gpm)

AC
(type power)

(7) electric log *—*
(yes or no)

(organization running log)

(8) how well bottom plugged *orange*

peel

DRILLERS REMARKS:

CODED


DEPT. OF NATURAL RESOURCES
BUREAU OF LAND & WATER RESOURCES

NOV 2 - 1981

RECEIVED

If well telescopes please sketch and show depths.

GROUND LEVEL

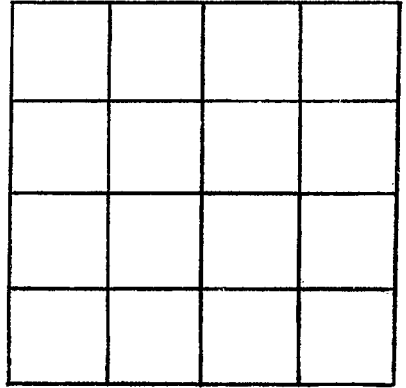

SECTION _____

Please indicate well location X.

ADDITIONAL INFORMATION

If more than one screen;
show locations of each on sketch.