

MISSISSIPPI DEPARTMENT OF NATURAL RESOURCES

Bureau of Land and Water Resources

Southport Mall

P.O. Box 10631

Jackson, Mississippi 39209 **CODED**

WATER WELL DRILLERS LOG

*Griner Drilling Service, Inc.*

*Marion*

MARION  
H 43  
10-31-81

10-31-81  
date well completed

Griner Drilling Service, Inc.  
firm name

Marion  
county well located

LANDOWNER:	description of formations encountered	from	to
SUN Gas P.O. Box 3358 Lafayette, La 70505 (mailing address)	red clay, sand	0	21
WELL LOCATION: 500' S 4500' E sec. 20 T 40 N R 17 E NW/40	sand + gravel	21	189
No! Gracie Springs 1.5 miles Improve Field (direction) of (nearest town)	sand + chalk	189	210
WELL PURPOSE: oil field supply (home, irrigation, municipal, industrial)	chalk	210	420
WELL COMPLETION DATA:	sand + gravel	420	525
(1) diameter (inches) 4"	chalk	525	546
(2) total depth (feet) 567'	chalk	546	567
(3) static water level (feet) 90' below top of ground.			
(4) casing steel 525' (material) (depth) 4" (size) if telescope see back.			
(5) screen 42' (length) 483' (depth to top) 4" perforated (size) (material)			
(6) pump — 75 (HP) (yield gpm) AC (type power)			
(7) electric log — (yes or no) (organization running log)			
(8) how well bottom plugged orange peel			
DRILLERS REMARKS:			


**CODED!**

DEPT. OF NATURAL RESOURCES  
BUREAU OF LAND & WATER RESOURCES

DEC 9 1981  
**RECEIVED**

If well telescopes please sketch and show depths.

GROUND LEVEL

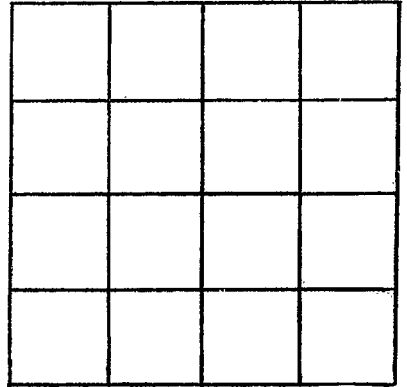

SECTION \_\_\_\_\_

Please indicate well location X.

ADDITIONAL INFORMATION

If more than one screen, show locations of each on sketch.