

Marion
H 2002
9/75

MISSISSIPPI
BOARD OF WATER COMMISSIONERS
416 North State Street
Jackson, Mississippi 39201

WATER WELL DRILLERS LOG

Sept. 25 1975 E. B. Sherrard Marion
date well completed name county well located

LANDOWNER:

Evelyn Robbins
Rt. 6 - Columbia, Ms.
(mailing address)

description of formations encountered

from to

GRAVEL HARD CLAY	0	80'
SAND & GRAVEL	80	105'

WELL LOCATION:

sec 33 T 4 N 13V
S R 17 E W
6 miles E of Columbia
(distance) (direction) (nearest town)

WELL PURPOSE:

(home, irrigation, municipal, industrial)

WELL COMPLETION DATA:

- (1) diameter (inches) 2"
- (2) total depth (feet) 105'
- (3) static water level (feet) 72' below top of ground.
- (4) casing (material) pl. (depth) 100'
- 2" (size) If telescope see back.
- (5) screen 5' (length) (depth to top)
- 2" (size) pl (material)
- (6) pump 1 (HP) 7 (yield gpm)
- E (type power)
- (7) electric log (yes or no) no

(organization running log)

(8) how well bottom plugged B/W


DRILLERS REMARKS:

RECEIVED
DEC - 5 1975

MISS. RD. OF WATER COMM

If well telescopes please sketch and show depths.

GROUND LEVEL

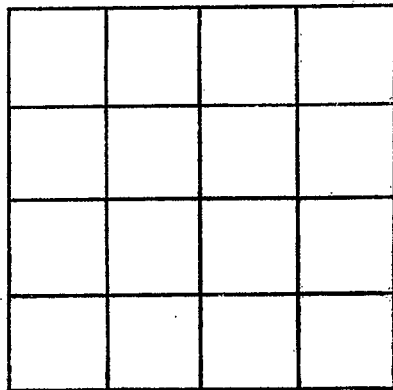

SECTION _____

Please indicate well location X.

ADDITIONAL INFORMATION

If more than one screen,
show locations of each on sketch.