

MARION  
 H 2005  
 6-16-77

MISSISSIPPI  
 BOARD OF WATER COMMISSIONERS  
 416 North State Street  
 Jackson, Mississippi 39201

WATER WELL DRILLERS LOG

June 16 1977 77 Dinn Well Sew Marion  
 date well completed firm name county well located

LANDOWNER:  
M. Gene Maree  
Rt. 1 Box 2870 Columbus  
 (mailing address)

description of formations encountered	from	to
<u>Top Soil</u>	<u>0</u>	<u>1</u>
<u>Clay</u>	<u>1</u>	<u>14</u>
<u>Chalk</u>	<u>14</u>	<u>68</u>
<u>Sand</u>	<u>68</u>	<u>115</u>

WELL LOCATION:  
 sec. 15 T. 4 N R. 18 E  
7 1/2 miles NE of Columbus  
 (distance) (direction) (nearest town)

WELL PURPOSE: Home  
 (home, irrigation, municipal, industrial)

- WELL COMPLETION DATA:
- (1) diameter (inches) 4"
  - (2) total depth (feet) 115 ft
  - (3) static water level (feet) 83 ft below top of ground.
  - (4) casing Plastic 105'  
 (material) (depth)  
4" if telescope see back.  
 (size)
  - (5) screen 10 ft 105 ft  
 (length) (depth to top)  
4" plastic  
 (size) (material)
  - (6) pump 3/4 12  
 (HP) (yield gpm)  
Elec  
 (type power)
  - (7) electric log no  
 (yes or no)
- (organization running log)

(8) how well bottom plugged B.W. Valve


DRILLERS REMARKS:

RECEIVED  
 OCT 25 1977

MISS. Bd. OF WATER COMMISSIONERS

If well telescopes please sketch and show depths.

GROUND LEVEL

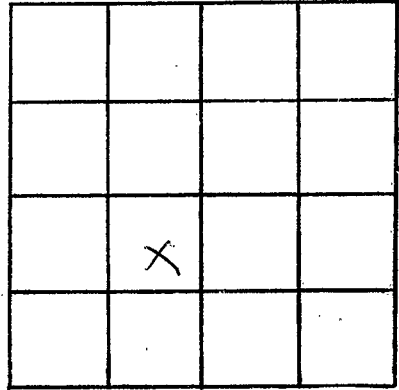

SECTION 7

Please indicate well location X.

ADDITIONAL INFORMATION

Lined area for additional information.

If more than one screen, show locations of each on sketch.