

MARION
H 2006
7-22-77

MISSISSIPPI
BOARD OF WATER COMMISSIONERS
416 North State Street
134 Jackson, Mississippi 39201

WATER WELL DRILLERS LOG

7/22/77 1977 Hollinger Well Marion
date well completed firm name county well located

LANDOWNER: Ed Rockinister
813 East Ave
Columbia, Miss
(mailing address)

description of formations encountered	from	to
CHALK, clay	0	35
Sand, of gravel	35	90

WELL LOCATION:
sec. 31 T. 40^N S. R. 17 E. W.
7 1/2 miles east of Columbia
(distance) (direction) (nearest town)

WELL PURPOSE: Home
(home, irrigation, municipal, industrial)

WELL COMPLETION DATA:

(1) diameter (inches) 2"

(2) total depth (feet) 90 ft.

(3) static water level (feet) 35 below top of ground.

(4) casing PVC, 80 (material) (depth)
(size) If telescope see back.

(5) screen 10, 80 (length) (depth to top)
2" PVC (size) (material)

(6) pump 1 (HP) 12 (yield gpm)
elect (type power)

(7) electric log (yes or no)
(organization running log)

(8) how well bottom plugged sand
3 1/2" x 1/2"

DRILLERS REMARKS: good well


RECEIVED

SEP 13 1977

MISS. BD. OF WATER COMMISSIONERS

If well telescopes please
sketch and show depths.

GROUND LEVEL

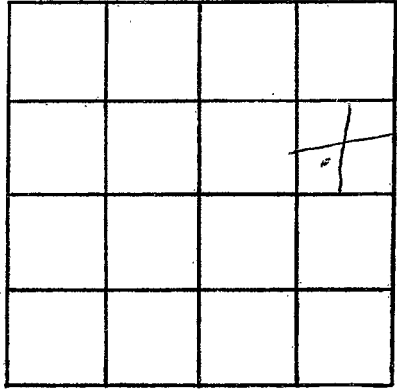

SECTION 31

Please indicate well location X.

ADDITIONAL INFORMATION

If more than one screen,
show locations of each on sketch.