

Marion
H 2007
10-7-77

MISSISSIPPI
BOARD OF WATER COMMISSIONERS
416 North State Street
13th Jackson, Mississippi 39201 LAUREL, MISS. 39440

C. P. Clark

WATER WELL DRILLERS LOG

10/7 1977 C. P. Clark Marion
date well completed firm name county well located


LANDOWNER: <u>Byron Smith</u>	description of formations encountered	from	to
<u>Rt 6 Box 216 A</u> <u>Columbia, Miss</u> (mailing address)			
WELL LOCATION: sec <u>2</u> T <u>N</u> R <u>17</u> E <u>7</u> miles <u>N</u> East of <u>Columbia</u> (distance) (direction) (nearest town)	<u>Clay</u>	<u>0</u>	<u>45</u>
	<u>Sand</u>	<u>45</u>	<u>50</u>
	<u>Blue Clay</u>	<u>50</u>	<u>81</u>
	<u>Sand</u>	<u>81</u>	<u>105</u>
	<u>Clay</u>	<u>105</u>	<u>110</u>
WELL PURPOSE: <u>Home</u> (home, irrigation, municipal, industrial)			
WELL COMPLETION DATA: (1) diameter (inches) <u>2</u>			
(2) total depth (feet) <u>105</u>			
(3) static water level (feet) <u>30</u> below top of ground.			
(4) casing <u>Galvanized 100</u> (material) (depth)			
(size) If telescope see back.			
(5) screen <u>5</u> <u>100</u> (length) (depth to top)			
<u>1/4</u> <u>Solid S. S. 606</u> (size) (material)			
(6) pump <u>1</u> <u>12</u> (HP) (yield gpm)			
<u>2200 1/2</u> (type power)			
(7) electric log <u>No</u> (yes or no)			
(organization running log)			
(8) how well bottom plugged <u>BWU</u>			
DRILLERS REMARKS: <u>Set 12A</u> <u>Jet @ 636 ft New</u> <u>Pump Stable</u>			

RECEIVED
OCT 18 1977

MISS. BD. OF WATER COMMISSIONERS

If well telescopes please sketch and show depths.

GROUND LEVEL

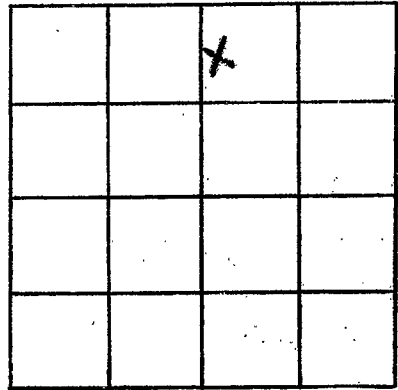

SECTION 2

Please indicate well location X.

ADDITIONAL INFORMATION

If more than one screen, show locations of each on sketch.