

MARION

H 208

9-12-78

MISSISSIPPI BOARD OF WATER COMMISSIONERS 416 North State Street Jackson, Mississippi 39201

WATER WELL DRILLERS LOG

9-12

1978 TOM GRIFFITH

Marion

date well completed

firm name

county well located

Ph & well sew

LANDOWNER:

Mr. Ronnie Riley Rt. 6 Box 234 Columbia Miss

description of formations encountered

from to

Top Soil	0	14
Clay	14	28
Sand	28	39
Chalk	39	52
Sand	52	85

WELL LOCATION:

sec. 36 T 4 N R 17 E S 7 miles E of Columbia

WELL PURPOSE: (home, irrigation, municipal, industrial)

WELL COMPLETION DATA:

- (1) diameter (inches) 4"
- (2) total depth (feet) 85 ft.
- (3) static water level (feet) 62 ft. below top of ground.
- (4) casing plastic, 75 ft. (material) (depth) 4" (size) if telescope see back.
- (5) screen 10 ft. 75 ft. (length) (depth to top) 4" (size) plastic (material)
- (6) pump 3/4 hp 12 (HP) (yield gpm) Electric (type power)
- (7) electric log no (yes or no)
- (organization running log)
- (8) how well bottom plugged Back Wash Valve


DRILLERS REMARKS:

RECEIVED NOV - 3 1978

MISS. BD. OF WATER COMMISSIONERS

If well telescopes please sketch and show depths.

GROUND LEVEL

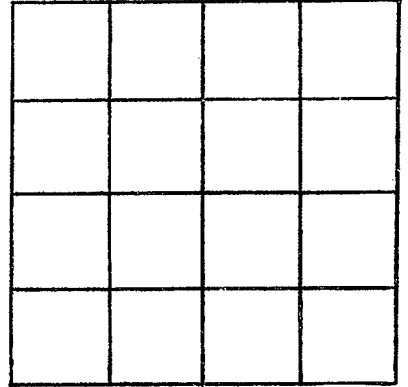

SECTION _____

Please indicate well location X.

ADDITIONAL INFORMATION

If more than one screen,
show locations of each on sketch.