

Marion
H 2009
9-11-81

MISSISSIPPI
BOARD OF WATER COMMISSIONERS
416 North State Street
Jackson, Mississippi 39201

WATER WELL DRILLERS LOG

9-11-81 19 Tom Griffith Well Serv Marion
date well completed firm name county well located

LANDOWNER:	description of formations encountered	from	to
Tupping Sears Box 555 Bryant (mailing address)	Top Soil Clay Red Sand White Sand	0 3 25 40	3 25 40 100
WELL LOCATION:			
sec. 20 T 4 N R 17 W 8 miles North of Columbia (distance) (direction) (nearest town)			
WELL PURPOSE: Home (home, irrigation, municipal, industrial)			
WELL COMPLETION DATA:			
(1) diameter (inches) 2 in			
(2) total depth (feet) 100 feet			
(3) static water level (feet) 60 below top of ground.			
(4) casing black 80' (material) (depth)			
if telescope see back. (size)			
(5) screen 2 in 100-80 (length) (depth to top)			
2 in plate (size) (material)			
(6) pump 1 10 (HP) (yield gpm)			
P/P (type power)			
(7) electric log NO (yes or no)			
N/A (organization running log)			
(8) how well bottom plugged B, Y, U			
DRILLERS REMARKS:			


DEPT. OF NATURAL RESOURCES
BUREAU OF LAND & WATER RESOURCES

OCT 20 1981

RECEIVED

If well telescopes please sketch and show depths.

GROUND LEVEL

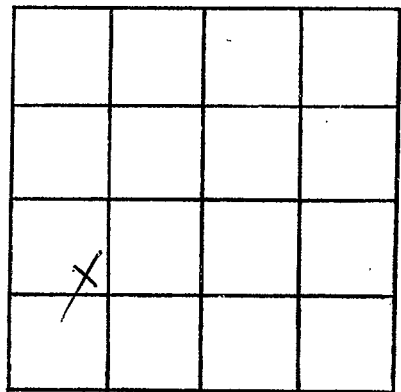

SECTION 20

Please indicate well location X.

ADDITIONAL INFORMATION

A series of horizontal lines for writing additional information.

If more than one screen, show locations of each on sketch.