

**MISSISSIPPI DEPARTMENT OF NATURAL RESOURCES**  
**Bureau of Land and Water Resources**  
 Southport Mall  
 P.O. Box 10631  
 Jackson, Mississippi 39209  
**WATER WELL DRILLERS LOG**

Monroe  
H  
2011

MAY 19 1983 Cochran Water Well Service Monroe  
 date well completed firm name county well located

**LANDOWNER:**  
John Parker  
Rt 3 Columbia  
 (mailing address)

| description of formations encountered | from | to  |
|---------------------------------------|------|-----|
| TOP SOIL                              | 0    | 2   |
| Red clay                              | 2    | 9   |
| GRAY CLAY                             | 9    | 13  |
| Sand                                  | 13   | 19  |
| blue clay                             | 19   | 102 |
| sand                                  | 102  | 132 |

**WELL LOCATION:**  
 sec. 35 T 4 N R 19 E  
 S W  
14 miles W of Belleview  
 (distance) (direction) (nearest town)

**WELL PURPOSE:**  
 home irrigation, municipal, industrial

**WELL COMPLETION DATA:**

(1) diameter (inches) 2"

(2) total depth (feet) 132.1

(3) static water level (feet) 21 <sup>(below)</sup> <sub>(above)</sub> top of ground.

(4) casing PVC, 122'  
 (material) (depth)  
       If telescope see back.  
 (size)

(5) screen 10' 122'  
 (length) (depth to top)  
2" PVC  
 (size) (material)

(6) pump 1 7  
 (HP) (yield gpm)  
Electric  
 (type power)

(7) electric log no  
 (yes or no)  
        
 (organization running log)

(8) how well bottom plugged valve

**DRILLERS REMARKS:**


DEPT. OF NATURAL RESOURCES  
 BUREAU OF LAND & WATER RESOURCES

AUG 17 1983

**RECEIVED**

If well telescopes please sketch and show depths.

GROUND LEVEL

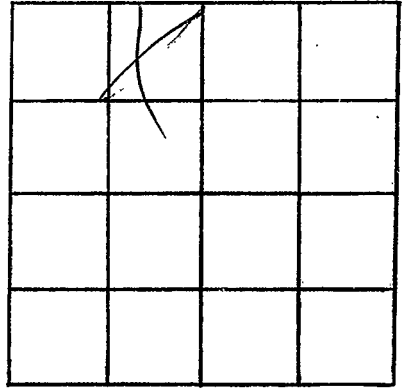

SECTION 35

Please indicate well location X.

ADDITIONAL INFORMATION

If more than one screen,  
show locations of each on sketch.