

MISSISSIPPI DEPARTMENT OF NATURAL RESOURCES

Bureau of Land and Water Resources

Southport Mall

P.O. Box 10631

Jackson, Mississippi 39209

WATER WELL DRILLERS LOG

MARION
H
2012

12-10-1985 date well completed Hollinger firm name MARION county well located


LANDOWNER: <u>Mike Williams</u>	description of formations encountered	from	to
<u>East Columbia</u> <u>Columbia, MS. 39425</u> (mailing address)			
	<u>SAND gravel</u>	<u>0</u>	<u>50</u>
	<u>CHALK</u>	<u>50</u>	<u>230</u>
	<u>COARSE SAND</u>	<u>230</u>	<u>250</u>

WELL LOCATION:
 sec. 5 T. 4N S. R. 17 E. W. 6
6 miles E of Columbia
 (distance) (direction) (nearest town)

WELL PURPOSE:
 (home) irrigation, municipal, industrial

- WELL COMPLETION DATA:
- (1) diameter (inches) 2 "
 - (2) total depth (feet) 250
 - (3) static water level (feet) 160 below top of ground.
 - (4) casing PVC, 240
 (material) (depth)
 - (size) if telescope see back.
 - (5) screen 10 240
 (length) (depth to top)
 - 2 PVC
 (size) (material)
 - (6) pump 2 5 pm
 (HP) (yield gpm)
 - elect
 (type power)
 - (7) electric log
 (organization running log)
 - (8) how well bottom plugged SAND
SHALK


DRILLERS REMARKS: Good well

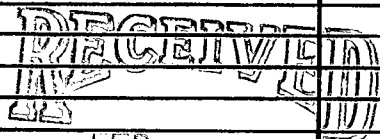

Department of Natural Resources
 Bureau of Land & Water Resources

If well telescopes please sketch and show depths.

GROUND LEVEL

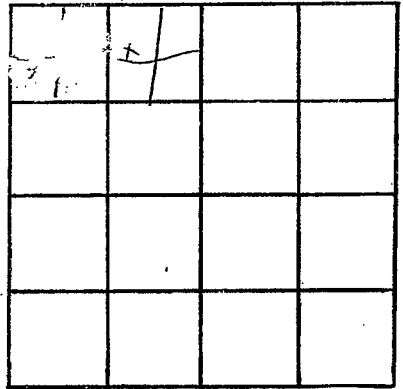

SECTION 5

Please indicate well location X.

ADDITIONAL INFORMATION

If more than one screen,
show locations of each on sketch.