

MISSISSIPPI DEPARTMENT OF NATURAL RESOURCES

Bureau of Land and Water Resources

Southport Mall

P.O. Box 10631

Jackson, Mississippi 39209

WATER WELL DRILLERS LOG

H 2013  
MARION  
2-28-85

2-28 1985

Hollinger

firm name

Marion

county well located

LANDOWNER: Johnny Stange

Gates Road

Columbia

(mailing address)

description of formations encountered.

from

to

chalk	0	80
sand, gravel	80	120
pea gravel	120	127

WELL LOCATION:

sec. 11 T. 40 N. R. 17 E. S. (W)  
8 miles N of Farmerville  
(distance) (direction) (nearest town)

WELL PURPOSE:

(home, irrigation, municipal, industrial)

WELL COMPLETION DATA:

- (1) diameter (inches) 2
- (2) total depth (feet) 127
- (3) static water level (feet) 60 below above top of ground.
- (4) casing PVC 117 (material) (depth)
- (size) if telescope see back.
- (5) screen 10 117 (length) (depth to top)
- 2 (size) (material)
- (6) pump 1 6 (HP) (yield gpm)
- elect (type power)
- (7) electric log (yes or no)

(organization running log)

(8) how well bottom plugged sand SHARK


DRILLERS REMARKS: Very good well

RECEIVED  
APR 4 - 1985

Department of Natural Resources  
Bureau of Land & Water Resources

If well telescopes please sketch and show depths.

GROUND LEVEL

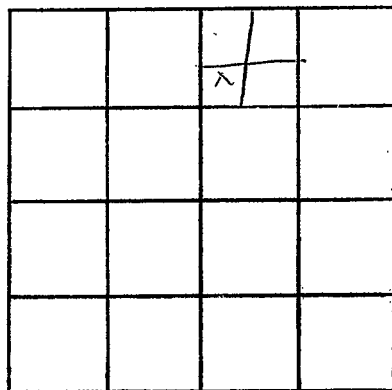

SECTION 11

Please indicate well location X.

ADDITIONAL INFORMATION

If more than one screen,  
show locations of each on sketch.