

MISSISSIPPI DEPARTMENT OF NATURAL RESOURCES

Bureau of Land and Water Resources

Southport Mall

P.O. Box 10631


Jackson, Mississippi 39209

WATER WELL DRILLERS LOG

Marion
H
2014

1-15 1986 Hollinger Marion
date well completed firm name county well located

LANDOWNER: <u>Truskmark</u>	description of formations encountered	from	to
<u>National Bank</u>			
<u>Columbia Ms 39429</u> (mailing address)	<u>CLAY, sand, gravel</u>	<u>0</u>	<u>24</u>
	<u>CHALK</u>	<u>24</u>	<u>80</u>
	<u>COARSE SAND</u>	<u>80</u>	<u>127</u>
<p>WELL LOCATION: sec <u>35</u> T <u>4N</u> S R <u>17</u> E <u>8</u> miles <u>E</u> of <u>Columbia</u> (distance) (direction) (nearest town)</p>			
<p>WELL PURPOSE: (home, irrigation, municipal, industrial)</p>			
<p>WELL COMPLETION DATA:</p>			
(1) diameter (inches) <u>2"</u>			
(2) total depth (feet) <u>127</u>			
(3) static water level (feet) <u>30</u> <u>below</u> above top of ground.			
(4) casing <u>pvc</u> <u>122</u> (material) (depth)			
<u> </u> if telescope see back. (size)			
(5) screen <u>6</u> <u>121</u> (length) (depth to top)			
<u>2</u> <u>pvc</u> (size) (material)			
(6) pump <u>1</u> <u>9</u> (HP) (yield gpm)			
<u>elect.</u> (type power)			
(7) electric log <u> </u> (yes or no)			
<u> </u> (organization running log)			
(8) how well bottom plugged <u>Sand</u> <u>SHANK</u>			
DRILLERS REMARKS: <u>Very good well</u>			

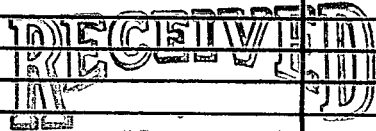


FEB -7 1986

Department of Natural Resources
Bureau of Land & Water Resources

If well telescopes please sketch and show depths.

GROUND LEVEL

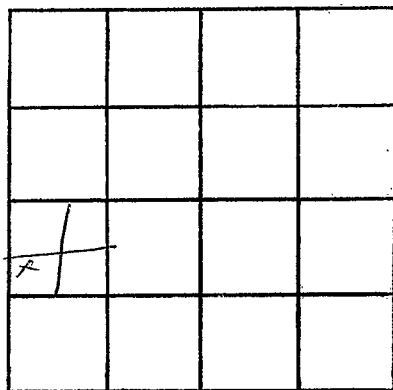

SECTION 35

Please indicate well location X.

ADDITIONAL INFORMATION

If more than one screen, show locations of each on sketch.