

MARION
H 2015

MISSISSIPPI DEPARTMENT OF NATURAL RESOURCES
Bureau of Land and Water Resources
Southport Mall
P.O. Box 10631
Jackson, Mississippi 39209
WATER WELL DRILLERS LOG

6-30 1986 Hollingen Marion
date well completed firm name county well located

LANDOWNER: Ted Breakfield
Rt 6
Columbia, Miss.
(mailing address)

description of formations encountered	from	to
	Red clay Sand, gravel	0 40

WELL LOCATION:
sec. 20 T 4 N R 17 E
5 miles SW of Improv
(distance) (direction) (nearest town)

WELL PURPOSE:
(home, irrigation, municipal, industrial)

WELL COMPLETION DATA:

(1) diameter (inches) 2 "

(2) total depth (feet) 100

(3) static water level (feet) _____ below above top of ground.

(4) casing pvc 90
(material) (depth)

_____ if telescope see back.
(size)

(5) screen 10 90
(length) (depth to top)

2 pvc
(size) (material)

(6) pump 1 8
(HP) (yield gpm)

elect
(type power)

(7) electric log _____
(yes or no)

_____ (organization running log)

(8) how well bottom plugged Sand SHARK


DRILLERS REMARKS: Very good well

REGISTERED
JUL 16 1986

Department of Natural Resources
Bureau of Land & Water Resources

If well telescopes please sketch and show depths.

GROUND LEVEL

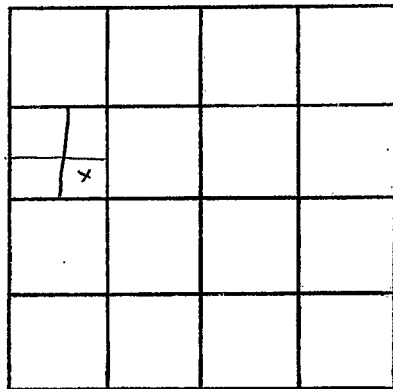

SECTION 20

Please indicate well location X.

ADDITIONAL INFORMATION

If more than one screen, show locations of each on sketch.