

MARION
H 2017

MISSISSIPPI DEPARTMENT OF NATURAL RESOURCES
Bureau of Land and Water Resources
Southport Mall
P.O. Box 10631
Jackson, Mississippi 39209
WATER WELL DRILLERS LOG

6-1-1990 date well completed
Hollinger Well firm name
Marion county well located

LANDOWNER: Robert Bullard
RT 6
Columbia, MS
(mailing address)

Description of formations encountered	from	to
Red clay	0	50
CHAFF	50	90
COARSE sand	90	135

WELL LOCATION:
sec. 34 T 4 N R 17 E
10 miles E of Columbia
(distance) (direction) (nearest town)

WELL PURPOSE:
(home, irrigation, municipal, industrial)

- WELL COMPLETION DATA:
- (1) diameter (inches) 4"
 - (2) total depth (feet) 135
 - (3) static water level (feet) 50 below top of ground.
 - (4) casing PVC, 135 (material), (depth)
If telescope see back.
(size)
 - (5) screen 10, 125 (length), (depth to top)
4", PVC (size), (material)
 - (6) pump 1/2, 12 (HP), (yield gpm)
elect (type power)
 - (7) electric log (yes or no)
(organization running log)

(8) how well bottom plugged SAND
SHARIC

DRILLERS REMARKS: Good Well


RECEIVED

JUL 23 1990

Department of Natural Resources
Bureau of Land & Water Resources

If well telescopes please sketch and show depths.

GROUND LEVEL

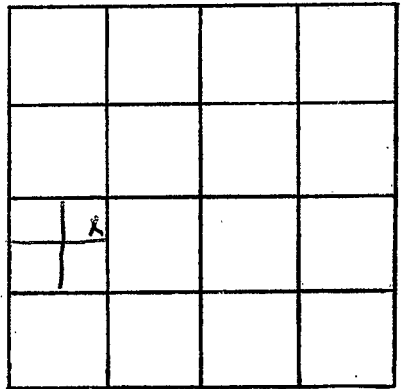

SECTION 34

Please indicate well location X.

ADDITIONAL INFORMATION

If more than one screen,
show locations of each on sketch.