

MISSISSIPPI DEPARTMENT OF ENVIRONMENTAL QUALITY

Office of Land and Water Resources

P. O. Box 10631
Jackson, MS 39289-0631
WATER WELL DRILLERS LOG

COUNTY WELL LOCATED <i>Madison</i>		
WELL NUMBER 2	CODED	PERMIT NUMBER 0-586
DATE WELL COMPLETED 11-8-95		NAME OF DRILLING FIRM James Wells
		Water Well Ser.

NAME & MAILING ADDRESS OF LANDOWNER
Jerry Tolar

2956 Hwy 98 East
Columbia Miss 39429

WELL LOCATION: SEC **25** TOWNSHIP **4** RANGE **17**
N **S** **E** **W**

DISTANCE **8** Miles **East** of **Columbia**

OTHER LANDMARK

WELL PURPOSE Home Irrigation, Municipal, Industrial, Fish Pond, etc.

PUMP DATA

PUMP TYPE (Circle One): Submersible Turbine Jet Flowing Well,
Other (Describe) _____

POWER TYPE (Circle One):
Electric, Tractor, Diesel, Gasoline, Butane,
Other (Describe) _____ H/P **2**

Pump Capacity (GPM)	No. of Stages	Setting Depth
		_____ FT.

PUMP TEST

Well yielded **25** GPM with
a drawdown of _____ ft.
after _____ hours of pumping

WELL DATA

Well Depth 135	Casing Diameter (In.) 4	Casing Length (Ft.) 115
Type of Casing PVC	Hole Depth 135	Depth to Static Water Level 50

TYPE OF COMPLETION: (Circle One or More):
 Gravel Packed Underreamed, Telescoped,
Natural Development, Open Hole, Other
(Describe) _____

WELL GROUTED TO A DEPTH OF _____ FEET
Type Grout (circle one): Cement Bentonite, or Mix

LOG DATA

TYPE OF LOG RUN (Circle One): _____ No Log Run,
Electric, Gamma Ray, Density, Sonic, Neutron,
Other (Describe) _____

Name of Organization Running Log

SCREEN DATA

Diameter - Inches 4	Length - Feet 20	Slot Size - Inches 08
Screen Type PVC SLOT	Depth to Bottom - Feet 115-135	

GEOLOGIC DATA (Office Use Only)

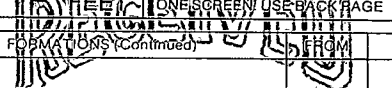
Surface Elev.	Geologic Unit	Unit Thickness	Depth to Top
Subs. SWL	Date	Analysis	Aquifer Test

Driller's Remarks

Top of Lap Pipe or Reduction in Casing

TELESCOPED OR MORE THAN ONE SCREEN USE BACK PAGE
 FEET
 FEET

DESCRIPTION OF FORMATIONS ENCOUNTERED	FROM	TO
Top Sand	0	3
Clay	3	80
Sand	80	135


JAN 08 1996
 Dept. of Environmental Quality
 Office of Land & Water Resources

IF MORE SPACE IS NEEDED, USE BACK

If well telescopes please
sketch and show depths.

GROUND LEVEL

SECTION _____

Please indicate well location X.

ADDITIONAL INFORMATION

If more than one screen,
show location of each on sketch.