

MISSISSIPPI DEPARTMENT OF NATURAL RESOURCES

Bureau of Land and Water Resources

Southport Mall

P.O. Box 10631

Jackson, Mississippi 39209

WATER WELL DRILLERS LOG

MARION
~~J~~
~~200~~

6-27 1985 Hollinzer Marion
 date well completed firm name county well located

LANDOWNER: Charles Cross RT 1	description of formations encountered	from	to
Foxworth, MS. (mailing address)	Sand, sandy clay chalk clay	0 10 30	10 30 50
WELL LOCATION: sec. 13 T 36(N) S R 20 E W 12 miles W of Foxworth (distance) (direction) (nearest town)	Sand, fine gravel	50	65
WELL PURPOSE: (home, irrigation, municipal, industrial)			
WELL COMPLETION DATA:			
(1) diameter (inches) 6 1/4"			
(2) total depth (feet) 65			
(3) static water level (feet) 10 below top of ground.			
(4) casing PVC, 55 (material) (depth) (size) if telescope see back.			
(5) screen 10, 55 (length) (depth to top)			
(6) pump 4, PVC (size) (material)			
(6) pump 1 1/2 (HP) 8 (yield gpm)			
(6) pump elect. (type power)			
(7) electric log (yes or no)			
(7) electric log (organization running log)			
(8) how well bottom plugged sand shale			
DRILLERS REMARKS: good well			


RECEIVED

AUG 15 1985

Department of Natural Resources
 Bureau of Land & Water Resources

If well telescopes please
sketch and show depths.

GROUND LEVEL

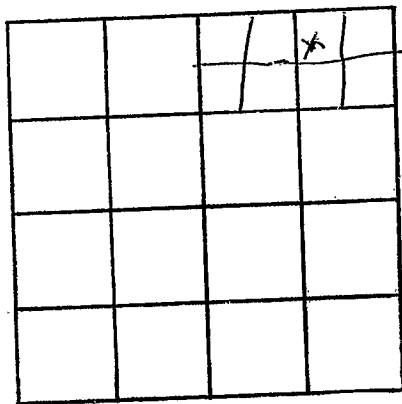

SECTION 13

Please indicate well location X.

ADDITIONAL INFORMATION

If more than one screen,
show locations of each on sketch.