

CODED

MARION
J 2
2-21-69

MISSISSIPPI
BOARD OF WATER COMMISSIONERS
416 North State Street
Jackson, Mississippi 39201

CODED

WATER WELL DRILLERS LOG

Feb 21 19 69 Fitzgerald Well Dr Marion
date well completed firm name county well located

LANDOWNER:
Murray Davis
R.R. Kalamo, Miss.
(mailing address)

description of formations encountered	from	to
<u>Red Clay</u>	<u>0</u>	<u>4</u>
<u>White Clay</u>	<u>4</u>	<u>20</u>
<u>Blue Clay</u>	<u>20</u>	<u>150</u>
<u>Course Sand</u>	<u>100</u>	<u>122</u>

WELL LOCATION:
sec 29 T 3 N R 12 E
9 miles NE of Lybilore
(distance) (direction) (nearest town)

WELL PURPOSE: Home
(home, irrigation, municipal, industrial)

- WELL COMPLETION DATA:
- (1) diameter (inches) 4"
 - (2) total depth (feet) 122'
 - (3) static water level (feet) 85 below above top of ground.
 - (4) casing black, 1 1/2" (material) (depth)
4 (size) if telescope see back.
 - (5) screen 6", 16" (length) (depth to top)
4 (size), plastic (material)
 - (6) pump 1/2 (HP) 10 (yield gpm)
elc (type power)
 - (7) electric log no (yes or no)
(organization running log)
 - (8) how well bottom plugged covered

CODED

CODED

CODED


MAR 12 1969

MISS. Bd. CE

DRILLERS REMARKS:

If well telescopes please sketch and show depths.

GROUND LEVEL

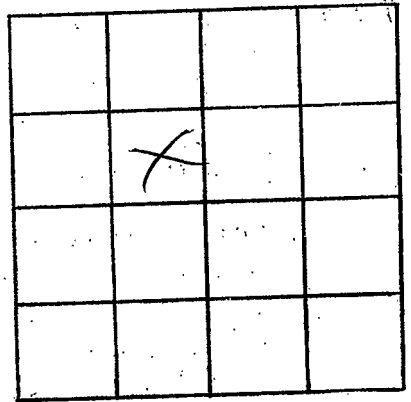

SECTION 29

Please indicate well location X.

ADDITIONAL INFORMATION

If more than one screen,
show locations of each on sketch.