

J A

WATER WELL DRILLERS LOG

CODED

12-21-62

Date: 12-21, 1962, Driller: F. B. Rowley County: Marion

FRED ROWLEY

(Name)

(1) Owner of Land: Fred Rowley (Name)

2017
Akokomo Mine (Address)

(2) Location: 1/4, 1/4, Sec. T R

17 3-12

3 miles of (distance) (direction) (Nearest Town)

(3) Topography: (Hilly) (Flat) (Level)

(4) Purpose of Well: Domestic (Domestic Irrigation, Municipal, Industrial, Other)

Information upon completion of well:

(1) Diameter 2 inches.

(2) Total Depth 132 feet.

(3) Water Level 50 feet below top of ground.

(4) Cased to 126, Size 4

(5) Screen: Size 2, Length 4

(6) Were any formations sealed against pollution?

yes, no.

If YES depth of formation:

Why:

Drillers Remarks:


Description & Color of Materials Sand, Clay, Red Clay, Shell, etc.

Thick-ness Feet

Depth Feet

40 feet
50 feet
10 feet

CODED

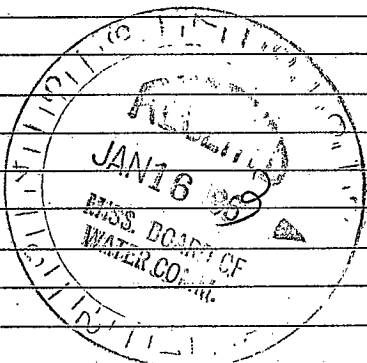

Well No.

(Use Back Side)

