

CODED

J 7
6-16-66

WATER WELL DRILLERS LOG

Date: 6/16, 1966, Driller: E. R. SHEPARD County MARION
(Name)

(1) Owner of Land: LEE R. SMITH
(Name)
FOXWORTH, MISS.
(Address)

(2) Location: 1/4, 1/4, Sec. 11 T3N R12W
10 miles WEST of Columbia.
(distance) (direction) (Nearest Town)

(3) Topography: (Hilly) (Flat) (Level)

(4) Purpose of Well: DOMESTIC
(Domestic Irrigation, Municipal, Industrial, Other)

Description & Color of Materials Sand, Clay, Red Clay, Shell, etc.	Thick- ness Feet	Depth Feet
RFD CLAY	10	
GRAY CLAY	30	
SAND	45	
HARD GRAY WITH STRAKS	"	
BLUE & BLACK CLAY	180	
SANDY FINE WHITE & GRAY	210	
COARSE WHITE + BLACK SAND	"	
DEA GR. SUEL	222	

Information upon completion of well:

(1) Diameter 2 inches.

(2) Total Depth 222 feet.

(3) Water Level 100 feet below top of ground.

(4) Cased to 222', Size 2"


(5) Screen: Size 2", Length 3'

(6) Were any formations sealed against pollution?
yes, no.

If YES depth of formation _____

Why _____

Drillers Remarks: _____

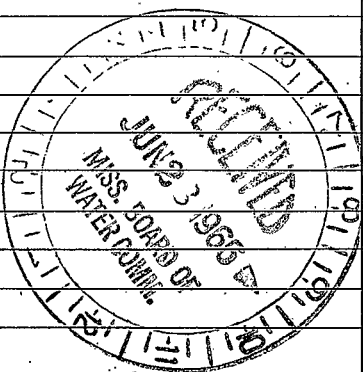

(Use Back Side)

Well No.

