

Marion
T. 10
12-66

MISSISSIPPI BOARD OF WATER COMMISSIONERS

CODED

WATER WELL DRILLERS LOG

Date: 12/22 19 66, Driller: T. B. Andrews County Marion
(When well drilled) (Name) (Where well is located)


(1) Owner of Land: J. W. Johnson
(Name)
Rt. 1 Kokomo Miss.
(Address)
 (2) Location: SW 1/4, SE 1/4, Sec. 28 T2R12
3
1/2 miles E of Kokomo
(distance) (direction) (Nearest Town)
 (3) Topography: Hilly
(Hilly) (Flat) (Level)
 (4) Purpose of Well: Domestic
(Domestic Irrigation
 Municipal, Industrial, Other)

Description & Color of Materials Sand, Clay, Red Clay, Shell, etc.	Thick- ness Feet	Depth Feet
<u>Red Clay</u>	<u>40'</u>	<u>40'</u>
<u>Sand</u>	<u>20'</u>	<u>60'</u>
<u>gray clay</u>	<u>40'</u>	<u>100'</u>
<u>fine Sand</u>	<u>20'</u>	<u>120'</u>
<u>Coarse Sand</u>	<u>17'</u>	<u>137'</u>
CODED		

Information upon completion of well:

(1) Diameter 4 inches.
 (2) Total Depth 137 feet.
 (3) Water Level 75 feet below top of ground.
 (4) Cased to 137', Size 4"
 (5) Screen: Size 4", Length 6"
 (6) Were any formations sealed against pollution?
 _____ yes, no.

If YES depth of formation _____
 Why _____
 Drillers Remarks: Plastic Well
 Yield in gpm: 10
 Size pump: 3/4 h.p.
 Type power: _____

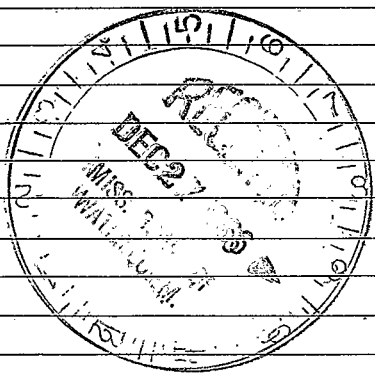

56

